

KANSAS

FORM 51 5M 10-41 PETROL


Mitchell

Section 1 Township 6 Range 7-W

Well No. #1 Black

Company Duffield-Emery & Coats

Wildcat

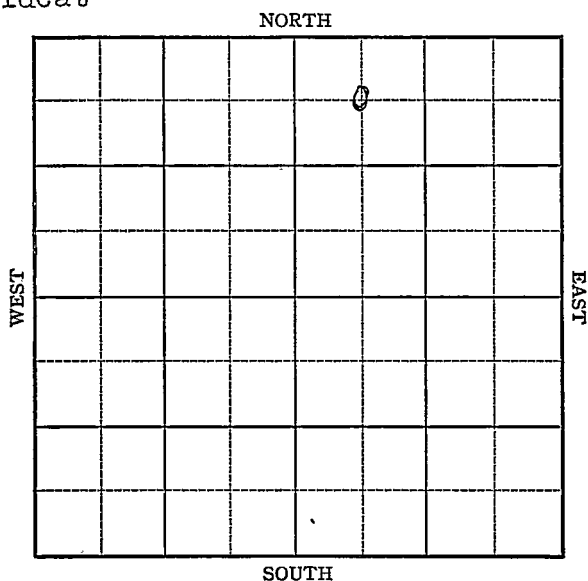


2

KANSAS

Mitchell

Sec. 1 Twp. 6 R. 7-WWell No. #1 Black FarmDuffield-Emery & Coats Company

Wildcat

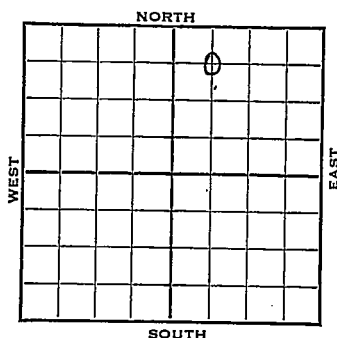660 Ft. from N. Line Ft. from S. Line Ft. from E. Line660 Ft. from W. Line

C NW NE Elev. 1561

1942

REPORT

12/2 Loc.

12/9 "

12/16 Notary

12/22 "

12/29 "

1943

1/6 12" casing set 55'
T.D. 1330' SD

1/13 Drlg. 2450'

1/20 Topeka 2121
Lans 2490
Miss 3166
Drlg. 3206'1/27 Houston 3395
Drlg. 3405'2/3 Viola 3586
Simp. sd. 3860
Arb. 3930
T.D. 3952'
No shows.**ABANDONED**

Mitchell

KANSAS

Map No. 129 Sec. 1 Twp. 6 R. 7WWell No. 1 Black

Duffield-Emery & Coats Company

FIRST REPORT

Contractor

C NW NE

660 Ft. from N. Line

Ft. from S. Line

Ft. from E. Line

660 Ft. from W. Line

SECTION PLAT

		o	

WILDCAT

Location XXX

Rig up

Drilling and Remarks:

RECORD

Cased _____ in., _____ ft.

Sand _____

Gas _____

Oil _____

Total Depth _____

PRODUCTION

1st 24 hrs. Nat. _____

1st 24 hrs. after shot _____

Gas _____ Cu. Ft.

Dry Hole _____

Abandoned _____

Date

DEC 2 1942

19

S. J. LEWIS

Scout

KANSAS

Map No. 129 Sec. 1 Twp. 6 R. 7WWell No. 1 BlackDuffield-Emery & Coats CompanyABANDONED Contractor

C NW NE

SECTION PLAT

660 Ft. from N. Line Ft. from S. Line Ft. from E. Line660 Ft. from W. Line

		o	

WILDCAT

Location Rig up

Drilling and Remarks:

*Vicla 3586**Comp Sh. 3860**Per 3930**No show*

RECORD

Cased in., ft.Sand Gas Oil Total Depth 3952

PRODUCTION

1st 24 hrs. Nat. 1st 24 hrs. after shot Gas Cu. Ft.Dry Hole Abandoned

Date

FEB 3 1943 19S. J. LEWIS Scout