

# KANSAS

Sheridan

Section 1 Township 6 Range 27W

Well No. 1 Kramer

Company Musgrove Pet.

Adel  
NORTH

WEST							EAST
	0						

SOUTH

12

Sec. 1 Twp. 6 R. 27W

Well No. #1 Kramer Farm

Musgrove Pet. Company

Adel Pool (B&R, Cont.)


990' Ft. from N. Line

\_\_\_\_\_ Ft. from S. Line

\_\_\_\_\_ Ft. from E. Line

330' Ft. from W. Line

SW NW SW

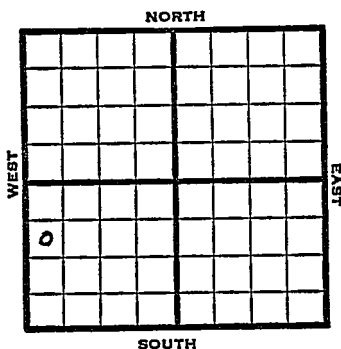

1949

Elev 2553' REPORT

8/3

Location

8/10

"

8/17

8" @ 241'  
Drlg 2175'

8/24

Lansing 3565  
Drlg 3687

8/31

Lans 3550 corrected  
TD 3775'  
5" @ 3769'

9/7

TD 3793' -  
PB 3368-29  
Shot 3562-66

9/14

No shows  
TD 3793'  
Lansing 3555'  
Aband.

**ABANDONED**

Map No. \_\_\_\_\_ Sec. 1 Twp. 6 R. 27W

Well No. 1 Kramer  
Musgrove Pet. \_\_\_\_\_ Company

B & R \_\_\_\_\_ Contractor

**FIRST REPORT  
SECTION PLAT**

SW NW SW


990 Ft. from N. Line

\_\_\_\_\_ Ft. from S. Line

\_\_\_\_\_ Ft. from E. Line

330 Ft. from W. Line

Sheridan County

**RECORD**

Location ✓

Cased \_\_\_\_\_ in., \_\_\_\_\_ ft.

Rig up \_\_\_\_\_

Sand \_\_\_\_\_

Drilling and Remarks:

Gas \_\_\_\_\_

Oil \_\_\_\_\_

Total Depth \_\_\_\_\_

**PRODUCTION**

1st 24 hrs. Nat. \_\_\_\_\_

1st 24 hrs. after shot \_\_\_\_\_

Gas \_\_\_\_\_ Cu. Ft.

Dry Hole \_\_\_\_\_

Abandoned \_\_\_\_\_

Date

AUG 3 1949 19

S. J. LEWIS Scout

Kansas

Map No. K135 Sec. 1 Twp. 6 R. 27W

Well No. 1 Kramer

Musgrove Pet. Company

**ABANDONED**

Contractor

SW NW SW

*E12553*

SECTION PLAT

990 Ft. from N. Line

         Ft. from S. Line

         Ft. from E. Line

330 Ft. from W. Line


Sheridan County

**RECORD**

Location                                 

Cased          in.,          ft.

Rig up                                 

Sand                                 

Drilling and Remarks:

Gas                                 

*Lane 8553*

Oil                                 

Total Depth 2293

**PRODUCTION**

1st 24 hrs. Nat.                                 

1st 24 hrs. after shot                                 

Gas                                  Cu. Ft.

Dry Hole                                 

Abandoned                                 

Date

SEP 14 1949 19

S I LEWIS Scout