


Section 1 Township 6 Range 18-W

Well No. #1 Faubin

Company G. L. Reeser

Faubin

NORTH

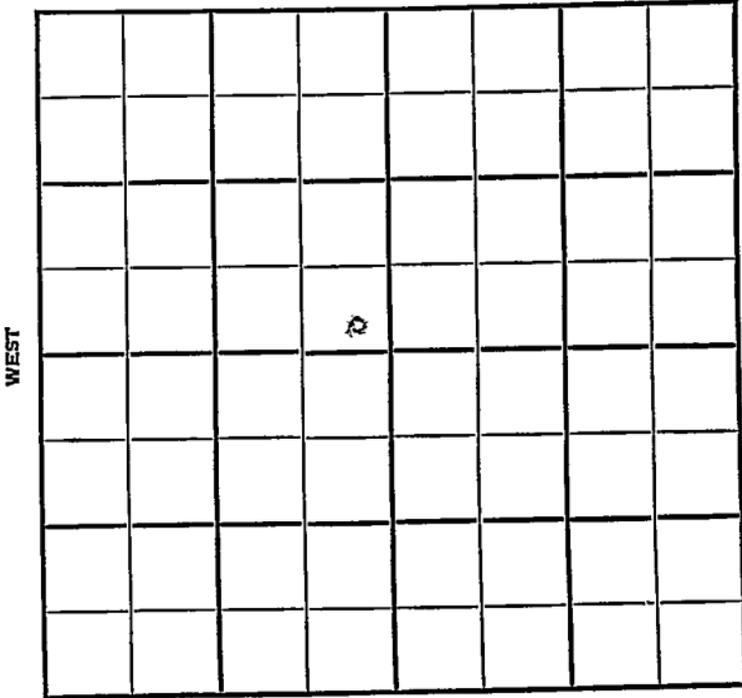

SOUTH

6

**KANSAS**

Rooks

Sec. 1 Twp. 6 R. 18W

Well No. #1 Faubin Farm

G. L. Reeser

Company

Faubin Pool


\_\_\_\_\_ Ft. from N. Line

330' Ft. from S. Line

330' Ft. from E. Line

\_\_\_\_\_ Ft. from W. Line

SE NW

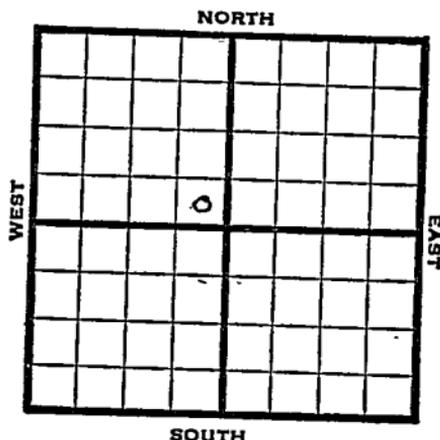

1948

**REPORT**

7/8

8" @ 170'  
470 Artesian Well  
D&A  
TD 470'

**FIRST REPORT**

**ABANDONED**

Map No. 132 Sec. 1 Twp. 6 R. 18W

Well No. 1 Faubin

G. L. Reeser Company

**FIRST REPORT**

Contractor

SE NW

*A. Hancock*

SECTION PLAT

\_\_\_\_\_ Ft. from N. Line

330 Ft. from S. Line

330 Ft. from E. Line

\_\_\_\_\_ Ft. from W. Line


**Rooks County**

Location \_\_\_\_\_

Rig up \_\_\_\_\_

Drilling and Remarks:

8" @ 170

470 Artesian  
well

D & A

RECORD

Cased \_\_\_\_\_ in., \_\_\_\_\_ ft.

Sand \_\_\_\_\_

Gas \_\_\_\_\_

Oil \_\_\_\_\_

Total Depth 470

PRODUCTION

1st 24 hrs. Nat. \_\_\_\_\_

1st 24 hrs. after shot \_\_\_\_\_

Gas \_\_\_\_\_ Cu. Ft.

Dry Hole \_\_\_\_\_

Abandoned \_\_\_\_\_

Date

JUL 8 1948 19\_\_\_\_\_

S. J. LEWIS Scout