KANSAS


Form 51—5M—4-36—Palace

Rooks

Section 1 Township 6 Range 18-W

Well Number #1-Southard

Company Eldorado Ref.

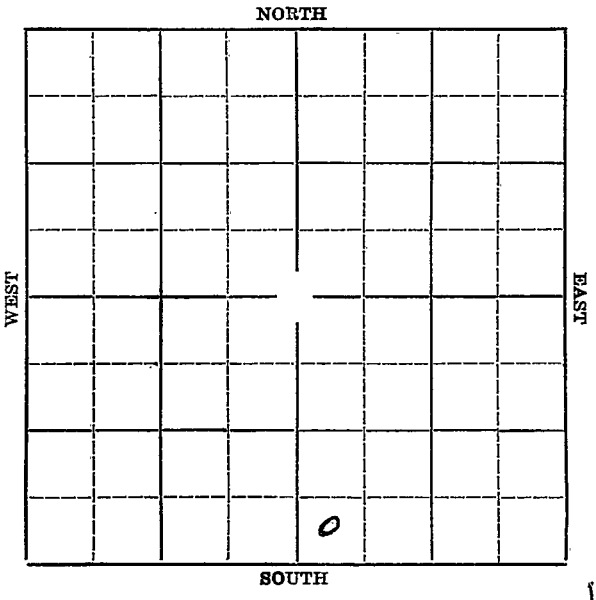

15

Form 252-A
5M 7-35 MPC

Rooks

Map No. KANSAS Sec. 1 Twp. 6 R. 18W

Well No. #1 Southard Farm


Eldorado Ref. Company

____ Ft. from N. Line

330' Ft. from S. Line

____ Ft. from E. Line

330 Ft. from W. Line

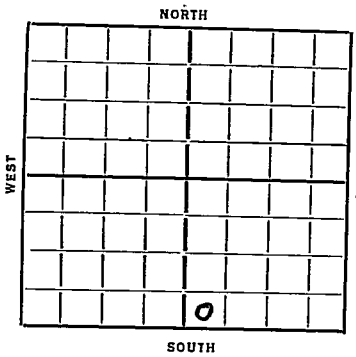

Elev. 1870

Date 1936	REPORT
8/12	Rig.
8/20	Drlg. 235'.
8/26	Drlg. 555'.
9/3	575' fishing.
9/10	42' o@ 20". 470' of 15½". 695' of 12½". Drlg. 725'.
9/18	Drlg. 11075'.
9/24	Drlg. 1267'.
10/1	1285' under ream 12".
10/8	Drlg. 1293'.
10/15	Drlg. 1295'.
10/22	10½ @ 1415'. Drlg. 1443'.
10/29	2153' under ream 10".
11/6	--
11/12	Fishing @ 2153
11/19	Drlg. 2365'.
11/27	Drlg. 2630'.
12/3	Drlg. 2770'. 8" @ 2678'.
12/10	Kansas City 3045'. Show oil 3048-53'. Under ream 8".

OVER

1936

12/17 8" @ 3045'. Drlg. 3063'.

12/24 Drlg. 3220'.

12/29 Shut down 3220'.

1/7/1937 6" @ 3250'.

Conglomerate 3268'. show oil 3279-87'. Water 3372'.
T. D. 3377' Underream 6".

1/14 Simpson 3407'. 7" @ 3425'. C.O

1/21 6" @ 3434'. Hole full water
Shut down 3458'.

1/28 Sil. 3420'. T. D. 3473'.
Shut down.

2/4 Plugging back to 3080 in the KCL

2/11 8" set at 3045', 1000 acid.
No test

2/17 Sil. 3420'.
T. D. 3473'.
P.B. 3080'.
K.C.L. 3045'.
7500 acid.
Potential 492.

COMPLETED

Form 26—1M Blks.—2-29

KANSAS


Map No. 132 Sec. 1 Twp. 6 R. 18W

Well No. 1 Southard

Eldorado Ry. Company

Contractor

SECTION PLAT

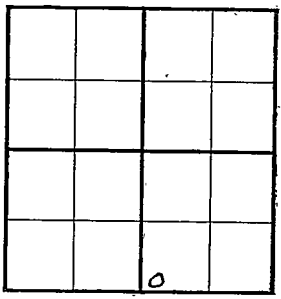

____ Ft. from N. Line

330 Ft. from S. Line

____ Ft. from E. Line

330 Ft. from W. Line

FIRST REPOI

Location ____

Rig up ____

Drilling and Remarks:

Rig

RECORD

Cased ____ in., ____ ft.

Sand ____

Gas ____

Oil ____

Total Depth ____

PRODUCTION

1st 24 hrs. Nat. ____

1st 24 hrs. after shot ____

Gas ____ Cu. Ft.

Dry Hole ____

Abandoned ____

Date

AUG 12 1936 19____

S. J. LEWIS Scout

~~Form 29—1M Bks.—2-29~~ KANSAS


Map No. 132 Sec. 1 Twp. 6 R. 18W

Well No. 1 Southard

EL Dorado Ref. Company

Contractor

SECTION PLAT

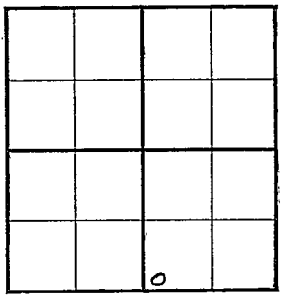

330 Ft. from N. Line

330 Ft. from S. Line

Ft. from E. Line

330 Ft. from W. Line

COMPLETED

Location

Rig up

Drilling and Remarks:

Sil 3420
P.B 3080
TCL 3045
7500 acid
Potential
492

RECORD

Cased in., ft.

Sand

Gas

Oil

Total Depth 3473

PRODUCTION

1st 24 hrs. Nat.

1st 24 hrs. after shot

Gas Cu. Ft.

Dry Hole

Abandoned

Date

FEB 17 1937 19

S. J. LEWIS Scout