

KANSAS

Rooks

Section 1 Township 6 Range 20WWell No. 1 GoleCompany Veeder Supply et al

Wildcat

|   |  |  |  |  |  |  |  |
|---|--|--|--|--|--|--|--|
|   |  |  |  |  |  |  |  |
|   |  |  |  |  |  |  |  |
|   |  |  |  |  |  |  |  |
|   |  |  |  |  |  |  |  |
|   |  |  |  |  |  |  |  |
| 0 |  |  |  |  |  |  |  |
|   |  |  |  |  |  |  |  |
|   |  |  |  |  |  |  |  |

NORTH

WEST

EAST

SOUTH

12

Rooks

KANSAS

Sec. 1 Twp. 6 R. 20W ✓

Well No. #1 Cole Farm

Veeder Supply et al Company

Wildcat (Veeder Supply, Cont.) NORTH

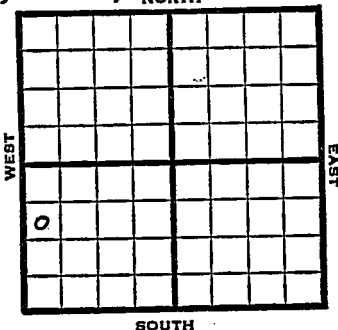
990' Ft. from N. Line

         Ft. from S. Line

         Ft. from E. Line

330' Ft. from W. Line

SW NW SW



1949

Elev. 2049' REPORT

7/13

8" @ 224'  
Topeka 3038'  
Lans. 3265'  
Drlg. 3309'

3265  
2049  
1216

3573  
2049  
1524

7/20

Granite 3573'  
TD 3573

**ABANDONED**

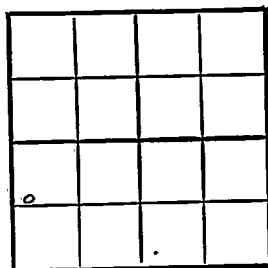
Kansas

Map No. \_\_\_\_\_ Sec. 1 Twp. 6 R. 20WWell No. 1 Cole

Veeder Supply etal. \_\_\_\_\_ Company

Veeder Supply \_\_\_\_\_ Contractor

SW NW SW

FIRST REPORT  
SECTION PLAT990 Ft. from N. Line

\_\_\_\_\_ Ft. from S. Line

\_\_\_\_\_ Ft. from E. Line

330 Ft. from W. Line

Rooks County

## RECORD

Location \_\_\_\_\_

Cased \_\_\_\_\_ in., \_\_\_\_\_ ft.

Rig up \_\_\_\_\_

Sand \_\_\_\_\_

Drilling and Remarks:

Gas \_\_\_\_\_

8" @ 224

Oil \_\_\_\_\_

Topeka 3038

Total Depth \_\_\_\_\_

Lans. 3265

drlg. 3309

## PRODUCTION

1st 24 hrs. Nat. \_\_\_\_\_

1st 24 hrs. after shot \_\_\_\_\_

Gas \_\_\_\_\_ Cu. Ft.

Dry Hole \_\_\_\_\_

Abandoned \_\_\_\_\_

Date

JUL 13 1949 19

S. J. LEWIS

Scout

Kansas

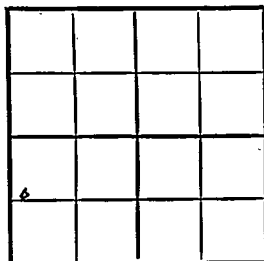
Map No. K133 Sec. 1 Twp. 6 R. 20WWell No. 1 Cole

Veeder Supply Company

**ABANDONED**

Contractor

SW NW SW

E1, 2048**SECTION PLAT**990 Ft. from N. Line         Ft. from S. Line         Ft. from E. Line330 Ft. from W. Line

Rooks County

**RECORD**Location                     Cased          in.,          ft.Rig up                     Sand                     

Drilling and Remarks:

Gas                     Oil                     Total Depth 3523**PRODUCTION**1st 24 hrs. Nat.                     1st 24 hrs. after shot                     Gas                      Cu. Ft.Dry Hole                     Abandoned                     

Date

JUL 20 194919S. J. LEWIS Scout