



1 KANSAS 6 21W

Sec. _____ Twp. _____ R. _____

Well No. #1 Probst Farm


Nadel & Gussman Company
Wildcat

_____ Ft. from N. Line

990 Ft. from S. Line

_____ Ft. from E. Line

330 Ft. from W. Line

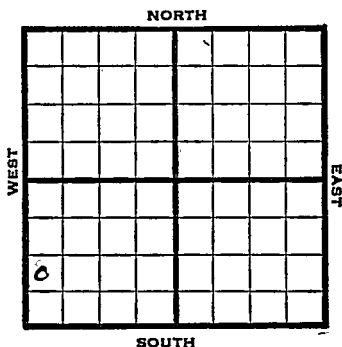

1947

Elev. 2115' REPORT

10/22

Location

10/29

8" @ 240'
Drlg. 700'

11/5

Drlg. 3212'

11/12

Quartzite 3505'
Granite 3522'
Lans. 3275'
Total 3528'

ABANDONED

Kansas Wildcat

Map No. _____ Sec. 1 Twp. 6 R. 21W

Well No. 1 Probst

Nadel & Gussman Company

FIRST REPORT Contractor

NW SW SW


SECTION PLAT

_____ Ft. from N. Line

990 Ft. from S. Line

_____ Ft. from E. Line

330 Ft. from W. Line

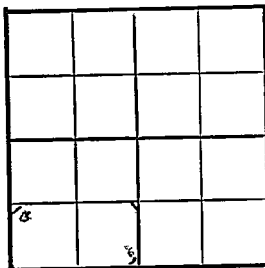

Graham County

Location X

Rig up _____

Drilling and Remarks:

RECORD

Cased _____ in., _____ ft.

Sand _____

Gas _____

Oil _____

Total Depth _____

PRODUCTION

1st 24 hrs. Nat. _____

1st 24 hrs. after shot _____

Gas _____ Cu. Ft.

Dry Hole _____

Abandoned _____

Date

OCT 22 1947

19

S. J. LEWIS

Scout

