

Sherman


KANSAS

SECTION 10 TOWNSHIP 6 RANGE 37W

WELL NO. #1 Llanos

COMPANY Phillips Petr.

NORTH C W/2 NW NE

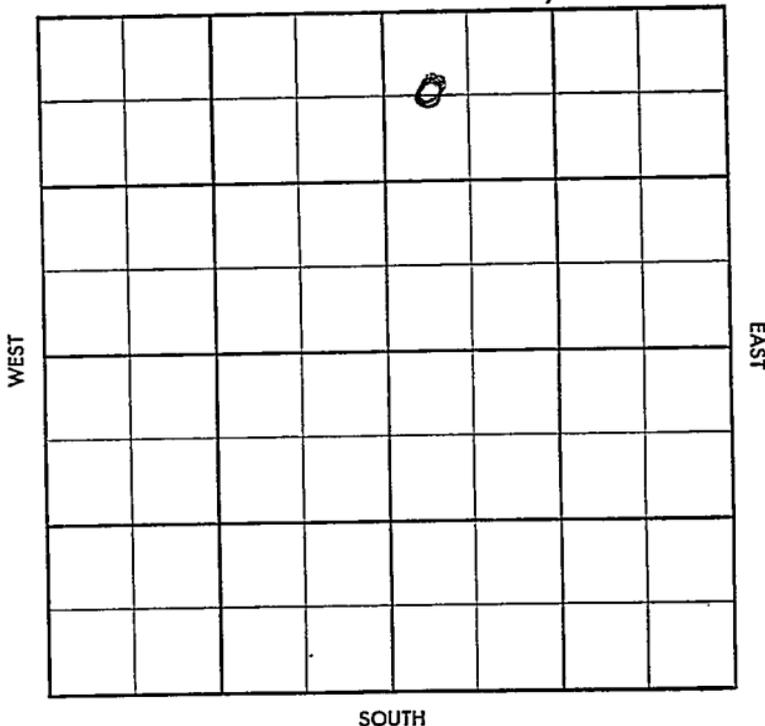

2

et

WILDCAT

2C.0

S-513-B

County Sherman Elev. _____
 Sec. 10 Twp. 6 Rge. 37W
 Company Phillips Pet.
 Farm Name Tlanos No. 1

TOPS	DEPTH	LOG	DATUM
Anh.			
Tp.			
H.			
Tr.			
Dg.			
B.L.			
L.			
K.C.			
B.K.C.			
Ce.			
C.			
M.			
M.			
K.			
Mz.			
Mq.			
V.			
S.			
S.			
A.			
R.			
Pf.			
G.			
T.D.			

Loc. in Sec. C W¹/₂ NW NE
Strat test
 Geol. _____
 Contr. _____
 Pool Wildcat

APR 30 1958
FIRST REPORT

Date Comm. 4-2-58

Co.

Lse.

No.

Sec.

T.

R.

Twp. ~~Pool~~

Co. ~~Facet~~

2c

6-513-B

County Sherman Elev. 3450 DE 3450 RB
 Sec. 10 Twp. 6 Rge. 37W
 Company Phillips Pet.
 Farm Name Llanos No. 1

TOPS	DEPTH	LOG	DATUM
Anh. Nibfara	1100		
Tp. <u>F. H.</u>	1540		
H. <u>B. Ft. H.</u>	1610		
Tr. <u>Dak</u>	2010		
Dg. <u>Anh</u>	3096		
B.L. <u>Q Anh</u>	3131		
L. <u>Neva</u>	3628		
K.C. <u>Forber</u>	3797		
B.K.C. <u>Admiral</u>	3823		
Ce. <u>Wab.</u>	3937		
C. <u>Houston</u>	4066		
M. <u>FP</u>	4089		
M. <u>Hb</u>	4242		
K. <u>Tor</u>	4272		
Mz. <u>Lkc</u>	4290		
Mq. <u>Bkl</u>	4541		
V. <u>Makm</u>	4548		
S. <u>Cher</u>	4749		
S. <u>M</u>	4947		
A.			
R.			
Pf.			
G.			
T.D.	5000	5001	

Loc. in Sec. C W 1/2 NW NE

Strat test

Geol.

Contr.

Pool

Wildcat

	0	
	JUN 3 '58	
COMPLETE		

Date Comm. 4-2-58

MAY 7 8" 370/200 ~~φ~~ 2 1/2" 4.05" PFP

~~1100~~ DST 1100-1337 9 hr 125' m vs lig
 rainbow no oil or taste FP 154-185

BHP 198-326/20" DST 4011-4121 1 hr

1930' MSW 600' SW NS FP 470

-1110 BHP 1190-1180/20" DST ~~4011~~

4197-4263 1 hr 155' MSW few 50ks

Dead oil FP 87-108 BHP 1270-1187/20"

DST 9273-9330 1 hr 300' WM few

SPKs dead oil DST 4332-95 1hr
 2000 MSW 1000' sulphur wtr FP
 415-1280 BHP 1320-1280/20" DST
 4455-87 1hr ~~1000~~ ~~500~~ 650' gssy
 oil 33.5% 450' gssy HOCM NW
 FP 69-452 BHP 1381/20 FBHP failed
 DST 4594-4611 3 720' gip 3290'
 Clean gssy oil 210' M.6 gco gr 29.8°
 FP 198-1200 BHP 1437-1373/20"
 DST 4611-18 1hr, g/30" ~~3000~~ 60'
 g b mcd 3470 Clean gray oil gr 30°
 120' g b mcd FP 218-1290 BHP 1443-
 1442/20" DST 4647-71 1hr 8' M NS
 All Press 45" DST 4683-98 1hr
 WB 11 min rec 90' M NS FP 34-58
 BHP 1344-1520/20" DST 4772-4800
 1hr 320' gip 182' oil FP 70-572 BHP
 1764-1581/20" gravity 26° DST
 4800-4833 1hr 60' gip 2875 clean
 gssy oil gr 41° FP 355-1047 BHP 1115-
 1080/20" DST 4950-5001 Mis-run DST
 4958-5001 1hr 2500' MSW FP 225-
 1145 BHP 1187-1162/20" 4 1/2" 5000/80
 van Log MICT MAY 21 '58 32/4804-12
 \$119.80 12 hrs 890 BS6M gr 23.4°
 \$9.36 BOPH 2 hrs tstg MAY 28 '58 \$11.9
 BOPH NW 5 hrs pop P 367 BO 35 hrs
 P 237 BO NW 22 hrs WD pot
 allow max 481 BO JUN 3 '58 Phyp 31980
 pd .4% BS6W gr 23° 4804-12
 10-6-37W character
 CW 1/2 NW NE