


Section 10 Township 6 Range 17-W

Well No. #1 Duncan

Company M. B. Armer  
Wildcat

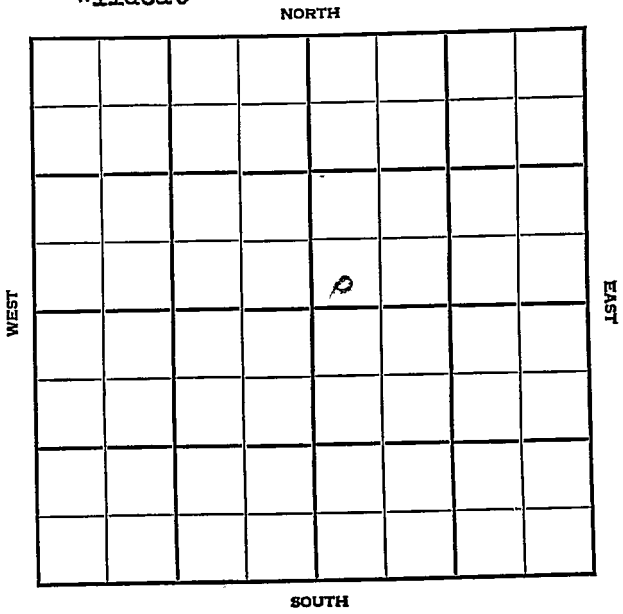

7

KANSAS

Rooks



Sec. 10 Twp. 6 R. 17W

Well No. #1 Duncan Farm

M. B. Armer Company


Wildcat

330' Ft. from N. Line

\_\_\_\_\_ Ft. from S. Line

\_\_\_\_\_ Ft. from E. Line

330' Ft. from W. Line

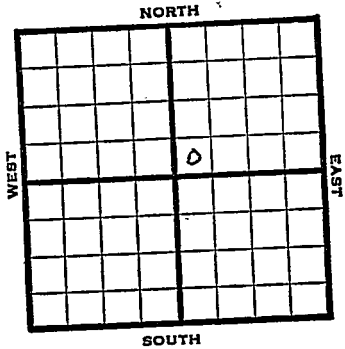

SW NE

1948

Eli. 1923'

REPORT

6/23

RUR

6/29

8" @ 195'  
Drlg. 2310'

7/14

TD 3618'  
Lansing 3083'  
Arb. 3588'  
Aband.

**ABANDONED**

Wildcat

Map No. 132 Sec. 10 Twp. 6 R. 17W

Well No. 1 Duncan  
M. B. Armer Company

**ABANDONED**

Contractor

E. J. 1923

SECTION PLAT

SW NE


         Ft. from N. Line  
330 Ft. from S. Line  
         Ft. from E. Line  
330 Ft. from W. Line

Rooks County

Location           
Rig up           
Drilling and Remarks:  
Lease 3083  
Act 3588

RECORD

Cased          in.,          ft.  
Sand           
Gas           
Oil           
Total Depth 2618

PRODUCTION

1st 24 hrs. Nat.           
1st 24 hrs. after shot           
Gas          Cu. Ft.  
Dry Hole           
Abandoned         

Date

JUL 14 1948 19 S. J. LEWIS Scout

Map No. \_\_\_\_\_ Sec. 10 Twp. 6 R. 17W

Well No. 1 Duncan

M. B. Armer Company

**FIRST REPORT**

Contractor

SW NE

**SECTION PLAT**


\_\_\_\_\_ Ft. from N. Line

330 Ft. from S. Line

\_\_\_\_\_ Ft. from E. Line

330 Ft. from W. Line

Rooks County

Location \_\_\_\_\_

Rig up \_\_\_\_\_

Drilling and Remarks:

R U R

**RECORD**

Cased \_\_\_\_\_ in., \_\_\_\_\_ ft.

Sand \_\_\_\_\_

Gas \_\_\_\_\_

Oil \_\_\_\_\_

Total Depth \_\_\_\_\_

**PRODUCTION**

1st 24 hrs. Nat. \_\_\_\_\_

1st 24 hrs. after shot \_\_\_\_\_

Gas \_\_\_\_\_ Cu. Ft.

Dry Hole \_\_\_\_\_

Abandoned \_\_\_\_\_

Date

JUN 23 1948

19

S. J. LEWIS

Scout