KANSAS

FORM 51 10M 8-47

~~Adell~~
Sheridan

Section 11 Township 6 Range 27W

Well No. 7 Cramer

Company Continental

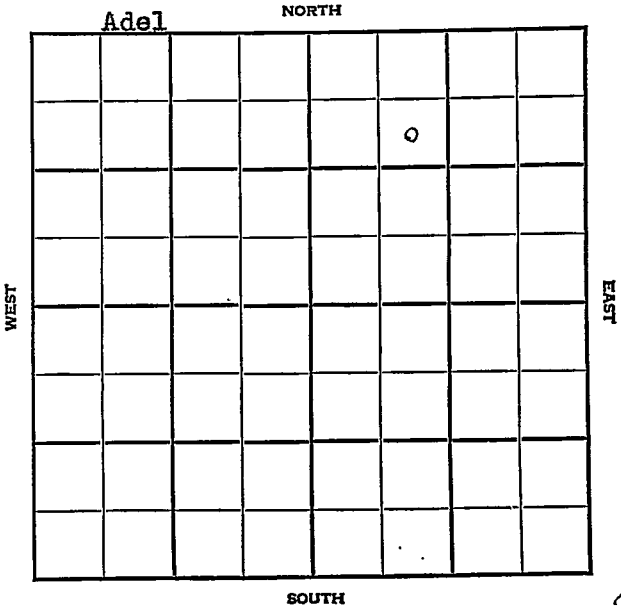

2

FORM 252-A
5M 9-47 PETROL

Sheridan KANSAS

Sec. 11 Twp. 6 R. 27W

Well No. #7 Cramer Farm

Continental Company

Adel

990 Ft. from N. Line

Ft. from S. Line

Ft. from E. Line

990 Ft. from W. Line

SE NW NE

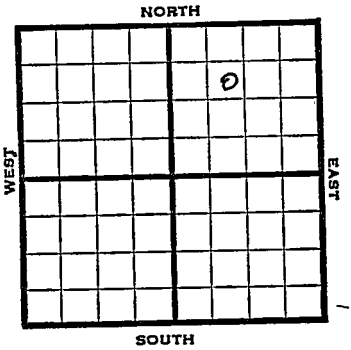

1947	Elev. 2645' REPORT
10/1	Location
10/8	10" @ 280' WOC
10/15	Drlg. 3387'
10/22	TD 3900' 6" @ 3899' RUST
11/5	Lansing 3613' 6" @ 3899' Perf. 500 acid Pump 714 Pot Gr. 34° Total Depth 3900' COMPLETED

Form 26 200 Bks. 10-46 Petrol

Kansas

Adel Pool

Map No. _____ Sec. 11 Twp. 6 R. 27W

Well No. 7 Cramer

Continental Company

FIRST REPORT Contractor

SE NW NE

990 Ft. from N. Line

_____ Ft. from S. Line

_____ Ft. from E. Line

990 Ft. from W. Line

SECTION PLAT

Sheridan County

Location x

Rig up _____

Drilling and Remarks:

RECORD

Cased _____ in., _____ ft.

Sand _____

Gas _____

Oil _____

Total Depth _____

PRODUCTION

1st 24 hrs. Nat. _____

1st 24 hrs. after shot _____

Gas _____ Cu. Ft.

Dry Hole _____

Abandoned _____

Date

OCT 1 1947 19

S. J. LEWIS Scout

Form 26 200 Bks. 10-46 Petrol

Adel Pool

Kansas

Map No. 135 Sec. 11 Twp. 6 R. 27W

Well No. 7 Cramer

Continental Company

COMPLETE Contractor

E1,2645

SE NW NE

SECTION PLAT

990 Ft. from N. Line

Ft. from S. Line

Ft. from E. Line

990 Ft. from W. Line

Sheridan Bounty

Location

Rig up

Drilling and Remarks:

4 ans 3613

6" @ 3899

Per f. 500 acid

Pump 714 Bd

34° Gr

RECORD

Cased in., ft.

Sand

Gas

Oil

Total Depth 3900

PRODUCTION

1st 24 hrs. Nat.

1st 24 hrs. after shot

Gas Cu. Ft.

Dry Hole

Abandoned

Date

NOV 5 1947 19

S. I. LEWIS Scout