

KANSAS

Section 11 Township 6 Range 27W

Well No. 1 Bouts

Company Peel & Hartman et al

Adel

NORTH

			0				

WEST

EAST

SOUTH

6

KANSAS

Sheridan



Sec. 11 Twp. 6 R. 27W

Well No. #1 Bouts Farm

Peel & Hartman et al Company

Adel


NORTH

_____ Ft. from N. Line

990' Ft. from S. Line

330' Ft. from E. Line

_____ Ft. from W. Line

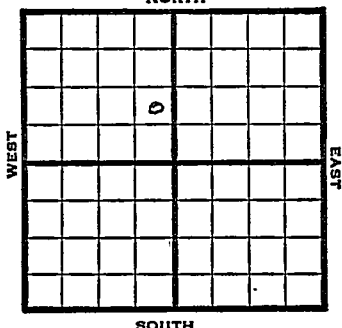

NE SE NW

SOUTH

1949

Elev. 2603' REPORT

2/9 Location

2/16 8" @ 294'
Drlg 3742'

2/23 Lansing 3607'
TD 3827'

3/2 5" @ 3826'
Lansing 3632' (Corrected)

3/8 12 shots 3662-66
1 wtr PH

3/16

3/23 72 shots 3635-39
24 " 3618-26 - 500 acid

3/30 Lans. 3632'
5" @ 3826'
Perf 1000 acid
TD 3827'

ABANDONED

Adel

Kansas

Map No. _____ Sec. 11 Twp. 6 R. 27 W

Well No. 1 Bouts

Peel & Hartman Et al Company

FIRST REPORT

Contractor

NESENW

SECTION PLAT

_____ Ft. from N. Line

990 Ft. from S. Line

330 Ft. from E. Line

_____ Ft. from W. Line

	0		

Shesidan

Location

Rig up _____

Drilling and Remarks:

RECORD

Cased _____ in., _____ ft.

Sand _____

Gas _____

Oil _____

Total Depth _____

PRODUCTION

1st 24 hrs. Nat. _____

1st 24 hrs. after shot _____

Gas _____ Cu. Ft.

Dry Hole _____

Abandoned _____

Date

FEB 9 1949 19

S. J. LEWIS

Scout

