

KANSAS

Sheridan County


FORM 51 5M BR1X

Section 11 Township 6 Range 27W

Well No. #1 A. F. Bouts

Company Continental

Adell

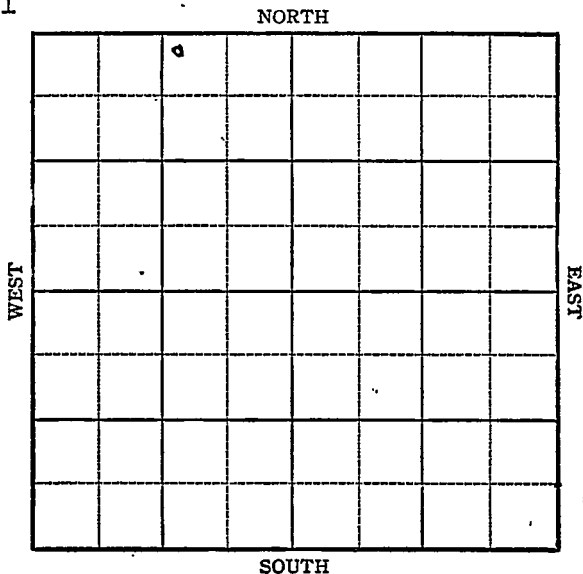

3

Sec. 11 Twp. 6 R. 27W

Well No. #1 A.F. Bouts Farm


Continental Company

330 Ft. from N. Line

 Ft. from S. Line

990 Ft. from E. Line

 Ft. from W. Line

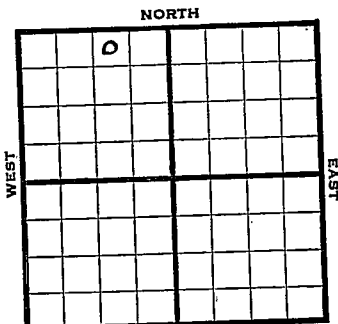

Elev. 2575 SOUTH NW NE NW

1944

REPORT

- 5/3 Location
- 5/10 "
- 5/17 Rotary
- 5/24 Surface Hole
- 5/31 10" @ 215'
Drlg. 2980
- 6/7 Drlg. 3602'
- 6/15 Lans 3605
Swb. 3605-40, 3658-70, 3690-3708
T.D. 3805-6" @ 3740
36 shots 3690-3708
Water squeeze Perf.
- 6/21 PB 3649 WOC
- 6/28 " " "
- 7/12 37 shots 3605-08 1700' oil in
2 hours
- 7/19 " " " " " " " "
- 7/26 " " " " " " " "
- 8/2 " " " " " " " "
- 8/9 " " " " " " " "
- 8/16 " " " " " " " "
- 8/23 " " " " " " " "

OVER

1944

8/30 Lans 3605
 6" @ 3740
 Perf. Lans
 TD 3805
 Pump 587 Pot.
 Grav. 36.

COMPLETED

Pool Name Adelle Pool

Map No. 130 Sec. 11 Twp. 6 R. 27W

Well No. I A. F. Bouts
Continental Company

COMPLETED Contractor

NW NE NW

SECTION PLAT

	0		

330 Ft. from N. Line
 _____ Ft. from S. Line
990 Ft. from E. Line
 _____ Ft. from W. Line

Sheridan

Location _____

Rig up _____

Drilling and Remarks:

*Lease 3605
 6" @ 3740
 Perf. Lease.
 Pump 587 Pd*

362

RECORD

Cased _____ in., _____ ft.
 Sand _____
 Gas _____
 Oil _____
 Total Depth 3805

PRODUCTION

1st 24 hrs. Nat. _____
 1st 24 hrs. after shot _____
 Gas _____ Cu. Ft.
 Dry Hole _____
 Abandoned _____

Date

AUG 30 1944 19 _____

S. J. LEWIS Scout

KANSAS

Pool Name NO

Map No. 135 Sec. 11 Twp. 6 R. 27W

Well No. 1 A. F. Bouts

Continental Company

FIRST REPORT Contractor

NW NE NW

SECTION PLAT

330 Ft. from N. Line

_____ Ft. from S. Line

990 Ft. from E. Line

_____ Ft. from W. Line

Sheridan County

Location X

Rig up _____

Drilling and Remarks:

RECORD

Cased _____ in., _____ ft.

Sand _____

Gas _____

Oil _____

Total Depth _____

PRODUCTION

1st 24 hrs. Nat. _____

1st 24 hrs. after shot _____

Gas _____ Cu. Ft.

Dry Hole _____

Abandoned _____

Date

MAY 3 1944 19 _____

S. J. LEWIS Scout