


Section 11 Township 6 Range 27-W

Well No. #1 Bouts "A"

Company Continental

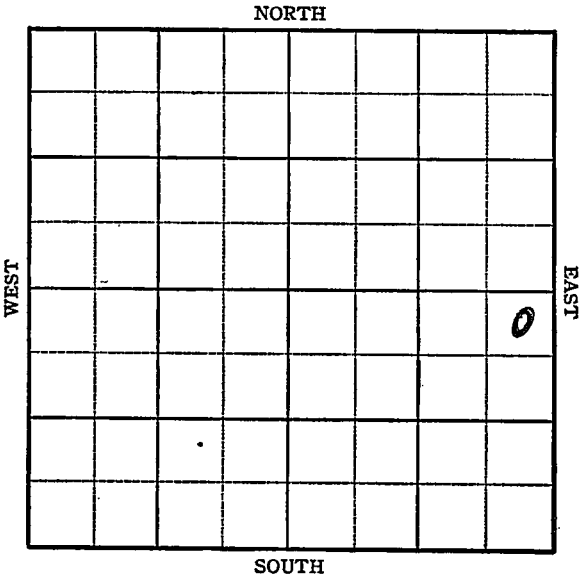

9

KANSAS

Sheridan County

Sec. 11 Twp. 6 R. 27W

Well No. #1 Bouts "A" Farm _____

Continental Company

Adel


330 Ft. from N. Line

330

_____ Ft. from S. Line

330 Ft. from E. Line

_____ Ft. from W. Line

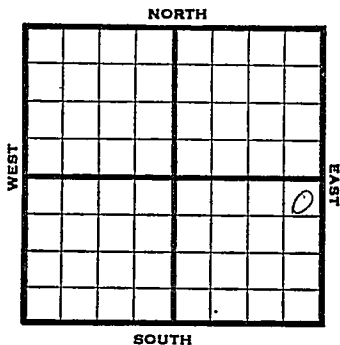

NE SE

1945 Elev. 2658 REPORT

12/19 10" @ 240' WOC

12/29 Drlg. 2734'

1946

1/10 T.D. 3885' 5" - 3883' RUS^T.

1/17 21 shots 3744-59 1 oil per hour.
1000 acid. Fsg.

1/24 Squeeze. P.B. to 3837'
73 shots 3775-3877'
Swab 266 oil in 7 hours.

1/31 " " "

2/7 " " "

2/14 " " "

2/21 " " "

2/28 " " "

3/7 " " "

3/14 " " "

3/21 " " "

3/27 Lans 3654
6" @ 3883
Perf. Lans. 1000 acid.
TD 3885'
Pump 706 Pot.
Grav. 33.0

COMPLETED

Kansas Pool Name Adel
KANSAS
 Map No. A-13 Sec. 11 Twp. 6 R. 27W

Well No. 1 Bouts "A"

Continental Company

FIRST REPORT Contractor

NE SE

SECTION PLAT

330 Ft. from N. Line

 Ft. from S. Line

330 Ft. from E. Line

 Ft. from W. Line

			o

Sheridan County

RECORD

Location

Cased in., ft.

Rig up

Sand

Drilling and Remarks:

Gas

10"-240 WOC

Oil

Total Depth

PRODUCTION

1st 24 hrs. Nat.

1st 24 hrs. after shot

Gas Cu. Ft.

Dry Hole

Abandoned

Date

DEC 19 1945 19

S. J. LEWIS Scout

KANSAS / Kansas Pool Name Adel

Map No. 33 Sec. 11 Twp. 6 R. 27W

Well No. 1 Bouts "A"

Continental Company

COMPLETED

Contractor

NE SE

E 12658
SECTION PLAT

330 Ft. from N. Line

_____ Ft. from S. Line

330 Ft. from E. Line

_____ Ft. from W. Line

			0

Sheridan County

Location _____

Rig up _____

Drilling and Remarks:

Lease 3654

6" @ 3883

*Perf Lease
1000 acid.*

Prod 706 ²⁸

33 @ gr.

RECORD

Cased _____ in., _____ ft.

Sand _____

Gas _____

Oil _____

Total Depth 3885

PRODUCTION

1st 24 hrs. Nat. _____

1st 24 hrs. after shot _____

Gas _____ Cu. Ft.

Dry Hole _____

Abandoned _____

Date

MAR 27 1946 19 _____

S. J. LEWIS

Scout