


Section 11 Township 6 Range 27W

Well No. 10 Bouts

Company Continental

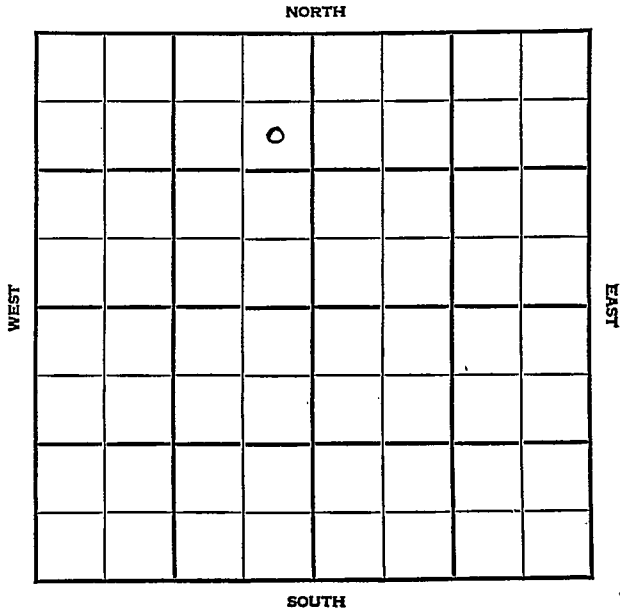



Sec. 11 Twp. 6 R. 27W

Well No. #10 Bouts Farm

Continental Company


Adel

990 Ft. from N. Line

\_\_\_\_\_ Ft. from S. Line

330 Ft. from E. Line

\_\_\_\_\_ Ft. from W. Line

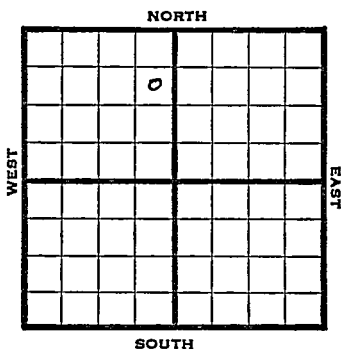

SE NE NW

1947 <sup>E</sup>lev. 2596 <sup>R</sup>REPORT

12/30 Location

<sup>7</sup>1948  
1/7 Drlg. 345'

1/14 8" @ 404  
Drlg 3207

1/21 Lansing 3570'  
TD 3840'  
6" @ 3839'  
RUST

2/26 "

2/4 48 shots 3671-89'  
Swb 20 bbls. WPH  
Squeeze.

2/11 58 shots 3614-44'  
44 shots 3585-3604'  
Swb. 8 bbls. oil PH 10 hrs.  
1000 acid.

2/18 Swb 40 Oil PH 4 hrs.

2/25 Lans. 3570' 6" @ 3839'  
Perf. 5000 acid Pump 715 Pot  
36.0 Gr.  
TD 3840'  
Comp.

**COMPLETED**

Adel Pool

Map No. \_\_\_\_\_ Sec. 11 Twp. 6 R. 27W

Well No. 10 Bouts

Continental Company

FIRST REPORT Contractor

SE NE NW

SECTION PLAT

990 Ft. from N. Line

\_\_\_\_\_ Ft. from S. Line

330 Ft. from E. Line

\_\_\_\_\_ Ft. from W. Line


Sheridan County

Location X

Rig up "

Drilling and Remarks:

RECORD

Cased \_\_\_\_\_ in. \_\_\_\_\_ ft.

Sand \_\_\_\_\_

Gas \_\_\_\_\_

Oil \_\_\_\_\_

Total Depth \_\_\_\_\_

PRODUCTION

1st 24 hrs. Nat. \_\_\_\_\_

1st 24 hrs. after shot \_\_\_\_\_

Gas \_\_\_\_\_ Cu. Ft.

Dry Hole \_\_\_\_\_

Abandoned \_\_\_\_\_

Date

DEC 30 1947 19

S. J. LEWIS Scout.

Map No. 135 Sec. 11 Twp. 6 R. 27W

Well No. 10 Bouts

Continental Company

**COMPLETE**

Contractor

SE NE NW

*E. 2596*  
SECTION PLAT

990 Ft. from N. Line

\_\_\_\_\_ Ft. from S. Line

330 Ft. from E. Line

\_\_\_\_\_ Ft. from W. Line


Sheridan County

Location \_\_\_\_\_

Rig up \_\_\_\_\_

Drilling and Remarks:

*have 3570  
6" @ 3839  
Perf  
500000  
Pump 715 P.D.*

*360/4*

RECORD

Cased \_\_\_\_\_ in., \_\_\_\_\_ ft.

Sand \_\_\_\_\_

Gas \_\_\_\_\_

Oil

Total Depth 3840

PRODUCTION

1st 24 hrs. Nat. \_\_\_\_\_

1st 24 hrs. after shot \_\_\_\_\_

Gas \_\_\_\_\_ Cu. Ft.

Dry Hole \_\_\_\_\_

Abandoned \_\_\_\_\_

Date

FEB 25 1948 19

S. J. LEWIS Scout