


Sheridan

Section 11 Township 6 Range 27W

Well No. #1 Cramer (Was #21 Strat)

Company Continental

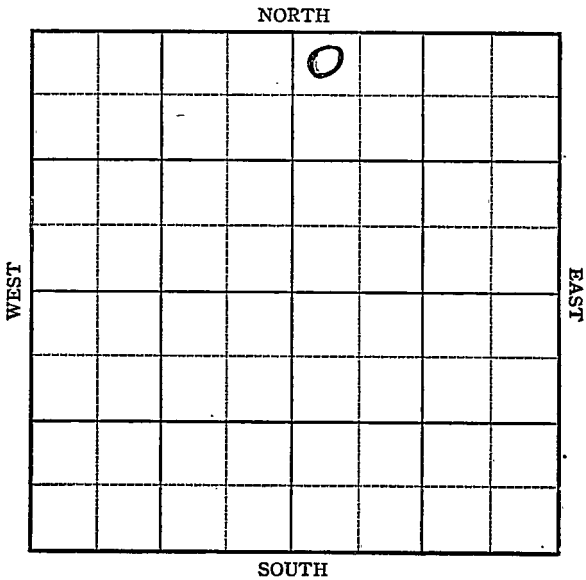

2

Sec. 11 Twp. 6 R. 27W

Well No. #1 Cramer (Was #21 Strat) Farm

Continental Company


Wildcat

330 Ft. from N. Line

Ft. from S. Line

Ft. from E. Line

330 Ft. from W. Line

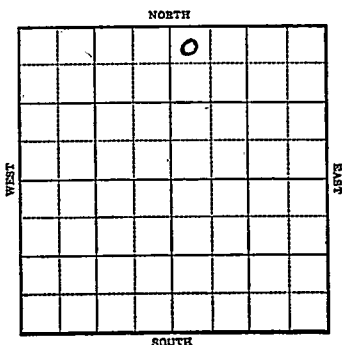

1944

R E P O R T

3/22

Lans. 3630 Stains
3630-34, 3649-54, 3672-75
3758-62. No Arb.
Granite Wash 4012
TD 4047 in Granite
5' - 3809 RUST

3/29

" " "

4/5

" " " "

4/10

Perforated 18 shots 3758 to 62
Swabbed 128 oil in 12 hours
Estimate 45 Gravity (Telegram)

4/12

Plug 3773
6 shots 3758-62
12 shots 3758-62
Swb 128 oil in 12 hrs
41.5 Gravity

4/19

1000 acid swb 50 oil PH fro 9 hrs off
bottom.

4/26

" "

5/3

" "

5/10

" "

5/17

" "

5/24

" "

5/31

" "

6/7

" "

OVER

1944

6/14 Lans 3630
Granite Wash 4012
5" @ 3809
Plug 3773 Perf. Lans 1000 acid
Pump 840 Pot.
Grav. 41.5
TD 4047'

COMPLETED

Map No. 135 Sec. 11 Twp. 6 R. 27W

Well No. 1 Cramer (Was #21 Strat)

Continental

Company

FIRST REPORT

Contractor

NW NE

SECTION PLAT

330


Ft. from N. Line

Ft. from S. Line

Ft. from E. Line

330

Ft. from W. Line

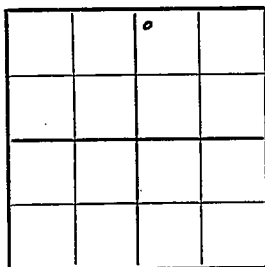

Wildcat

RECORD

Location

Cased _____ in., _____ ft.

Rig up

Sand _____

Drilling and Remarks:

Gas _____

Lens. 3630 Steins

3630-34, 3649-

54, 3672-75,

3758-62. No Arb.

Total Depth _____

Granite Wash

4012 TD 4047 in

Granite

5' - 3809 RUST

PRODUCTION

1st 24 hrs. Nat. _____

1st 24 hrs. after shot _____

Gas _____ Cu. Ft.

Dry Hole _____

Abandoned _____

Date

MAR 22 1944

19

S. J. LEWIS

Scout

KANSAS

Pool Name Adel Pool

Map No. 135 Sec. 11 Twp. 6 R. 27W

Well No. 1 Cramer (Was #21 Strat)

Continental Company

COMPLETED

Contractor

NW NE

SECTION PLAT

		6	

330 Ft. from N. Line

Ft. from S. Line

Ft. from E. Line

330 Ft. from W. Line

Sheridan County

RECORD

Location

Cased _____ in., _____ ft.

Rig up

Sand _____

Drilling and Remarks:

Gas _____

Loss 3630

Oil _____

Granite Mark 4012

Total Depth 4047

3" 3809

PRODUCTION

Plug 3773 Prod. Loss

1st 24 hrs. Nat. _____

1000 acid

1st 24 hrs. after shot _____

Plug 840 Prod

Gas _____ Cu. Ft.

415 SW

Dry Hole _____

Abandoned _____

Date

S. J. LEWIS

Scout

JUN 14 1944 19