KANSAS

FORM 51 5M BRIX


Sheridan County

Section 11 Township 6 Range 27W

Well No. #2 C. Cramer

Company Continental

Adel

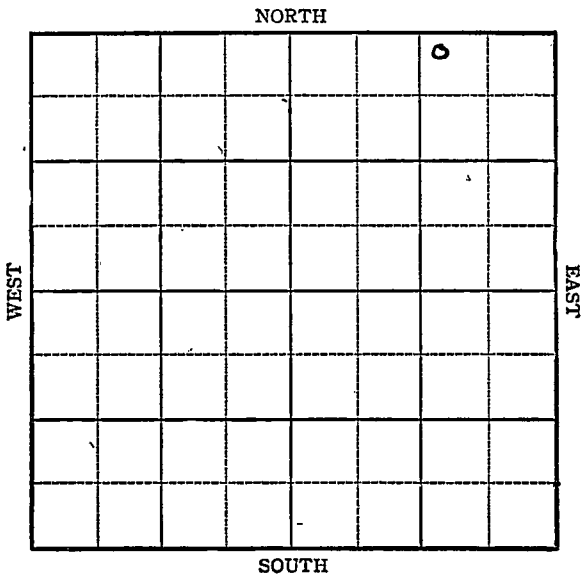

FORM 252-A
5M 3-44 PETROL

KANSAS

Sheridan

Sec. 11 Twp. 6 R. 27W

Well No. #2, C. Cramer Farm

Continental Oil Company


Adel

330 Ft. from N. Line

Ft. from S. Line

990 Ft. from E. Line

Ft. from W. Line

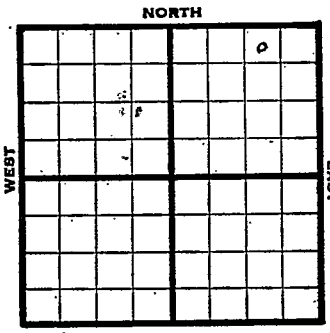

Elev. 2626

NW NE NE

1944	REPORT
6/14	Location
6/21	Derrick
6/28	10" @ 240 WOC
7/12	Lans 3600 SO 3600-02 36-7-19 3645-50 TD 3800 6" @ 3793 RUST
7/19	" " " " " " " " "
7/26	6" @ 3767 Corrected. Recemented WOC
8/2	Swb 5 oil per 4 hrs. off bottom
8/9	61 shots 3606-22½ 50 " 3642-50, 12 " 3668-75 24 " 3685-93 24 " 3703-08 1500 acid 3685-93 Swb 60 oil plus 200 wtr. in 2 hrs.
8/16	Retained 3679 Squeeze Perf. 3685-93 & 3703-08 WOC
8/23	PB 3680 500 acid HFO
8/30	Lans 3612 6" @ 3767 Perf. Lans Pump 1097 Pot. TD 3800 Grav. 36. COMPLETED

FORM 26 200 BKS. 1 44 PETROL

KANSAS

Pool Name Adel

Map No. 133 Sec. 11 Twp. 6 R. 27W

Well No. 2 C. Cramer

Continental Company

FIRST REPORT Contractor

NW NE NE


330 Ft. from N. Line

Ft. from S. Line

990 Ft. from E. Line

Ft. from W. Line

SECTION PLAT

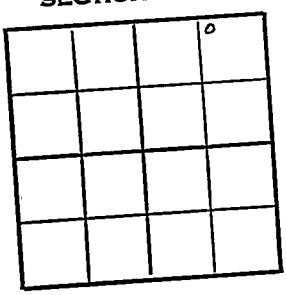

Sheridan County

Location X

Rig up

Drilling and Remarks:

RECORD

Cased in., ft.

Sand

Gas

Oil

Total Depth

PRODUCTION

1st 24 hrs. Nat.

1st 24 hrs. after shot

Gas Cu. Ft.

Dry Hole

Abandoned

Date

JUN 14 1944 19

S. I. LEWIS Scout

FORM 26 200 BKS. 2-44 PETROL

Pool Name Adel Pool

Map No. 135 Sec. 11 Twp. 6 R. 27 W

Well No. 2 C. Cramer

Continental Company

COMPLETED Contractor

NW NE NE


330 Ft. from N. Line

Ft. from S. Line

990 Ft. from E. Line

Ft. from W. Line

SECTION PLAT

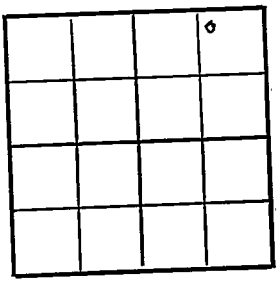

Sheridan

Location

Rig up

Drilling and Remarks:

Lans. 3612.
.6 "C" 3767
Perf Lans.
Pump 1097 Bbl
36° Gr

RECORD

Cased in., ft.

Sand

Gas

Oil

Total Depth 3800

PRODUCTION

1st 24 hrs. Nat.

1st 24 hrs. after shot

Gas Cu. Ft.

Dry Hole

Abandoned

Date

AUG 30 1944 19

S. J. LEWIS Scout