


KANSAS

FORM 51 5M PETROL

Section 11 Township 6 Range 27W

Well No. 3 Cramer

Company Continental

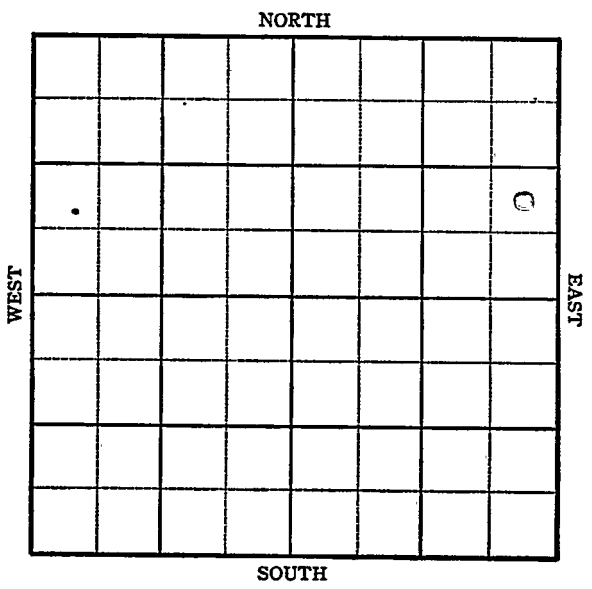

8

KANSAS

Sheridan

Sec. 11 Twp. 6 R. 27-W

Well No. #3 Cramer Farm


Continental Company

 Ft. from N. Line

990 Ft. from S. Line

330 Ft. from E. Line

 Ft. from W. Line

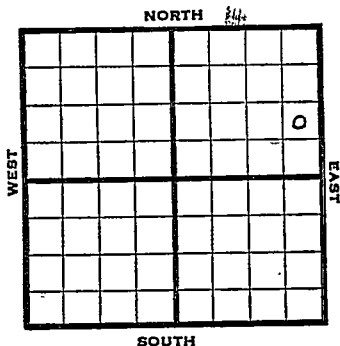

NE SE NE

1945	Elev. 2639'	REPORT
10/17	Derrick	
10/24	252 Run 10"	
10/31	Drig. 2380'	
11/7	Drig. " 3662'	
11/14	Lans 3623	
	TD 3877	
	6" @ 3865' RUST	
11/21	" " "	
11/28	PB 3852	
	36 shots 3706-3728	
	Swab 120 oil plus 8½ Wtr. in 48 hrs.	
12/5	36 shots 3737-3755	
	24 shots 3775-3784	
	60 shots 3801-3828	
	24 shots 3841-3850 swb. 17 oil per hr.	
12/12	" " " " " "	
12/29	Lans 3623	
	6" @ 3865	
	Perf.	
	TD 3877	
	Pump 509 oil plus 11% wtr. Pot.	
	Grav. 36.0	

COMPLETED

KANSAS

Kansas Pool Name Adel

Map No. 136 Sec. 11 Twp. 6 R. 27W

Well No. 3 Cramer

Continental Company

FIRST REPORT Contractor

NE SE NE

SECTION PLAT

 Ft. from N. Line
990 Ft. from S. Line
330 Ft. from E. Line
 Ft. from W. Line

			D

Sheridan County

RECORD

Location _____
 Rig up _____
 Drilling and Remarks:
 derrick

Cased _____ in., _____ ft.
 Sand _____
 Gas _____
 Oil _____
 Total Depth _____

PRODUCTION

1st 24 hrs. Nat. _____
 1st 24 hrs. after shot _____
 Gas _____ Cu. Ft.
 Dry Hole _____
 Abandoned _____

Date

OCT 17 1945 19 S. J. LEWIS Scout

