


Section 11 Township 6 Range 27-W

Well No. #4 C. Cramer

Company Continental

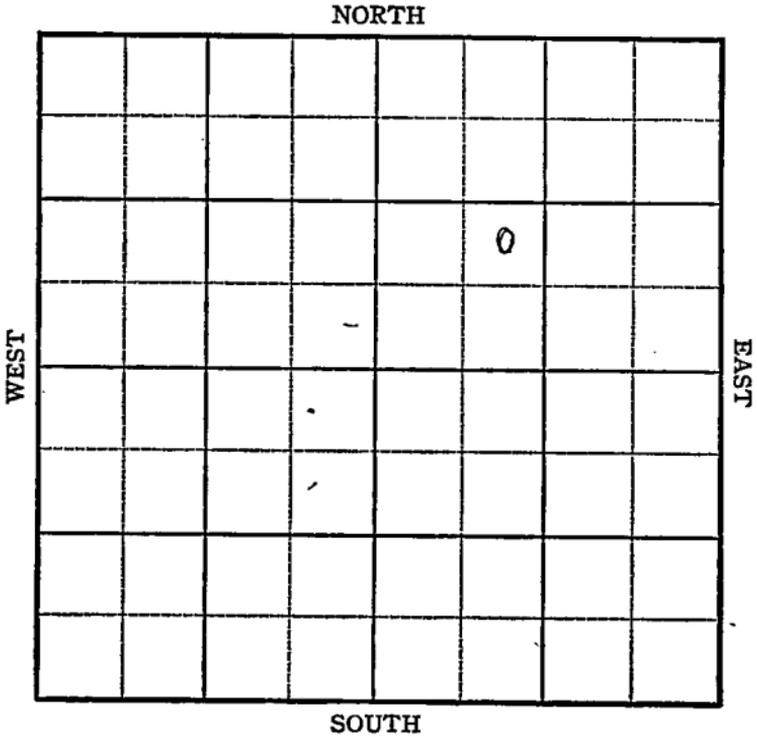

7

KANSAS

Sheridan County ✓

Sec. 11 Twp. 6 R. 27W

Well No. #4 C. Cramer Farm _____

Continental Company


Adel

_____ Ft. from N. Line

990 _____ Ft. from S. Line

_____ Ft. from E. Line

990 _____ Ft. from W. Line

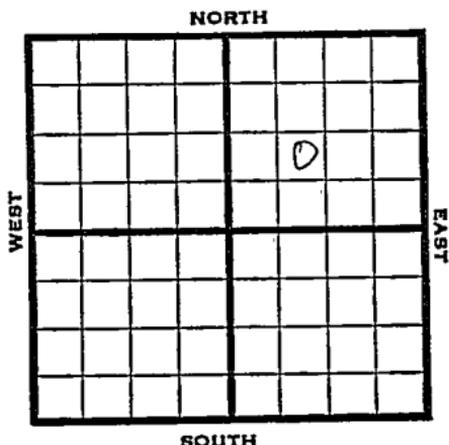

NE SW NE

1946 Elev. 2632 REPORT

- 3/6 Location
- 3/14 R.U.R.
- 3/21 10" - 240' Drlg. 2035'
- 3/28 Drlg. 3467'
- 4/4 Lans 3617
TD 3868'
8" @ 3866 RUST
- 4/10 22 shot 3712-30
8 W PH 6 hrs.
Squeeze Perf
- 4/17 Lans 3617
6" @ 3866
Perf. Lans. 1000 acid.
TD 3868
Pump 925 Pot.
Grav. 38.0

COMPLETED

KANSAS Kansas Pool Name Adel

Map No. 137 Sec. 11 Twp. 6 R. 27W

Well No. 4 C. Cramer

Continental Company

FIRST REPORT Contractor

NE SW NE

SECTION PLAT

 Ft. from N. Line

990 Ft. from S. Line

 Ft. from E. Line

990 Ft. from W. Line

		o	

Sheridan County

Location K

Rig up

Drilling and Remarks:

RECORD

Cased in., ft.

Sand

Gas

Oil

Total Depth

PRODUCTION

1st 24 hrs. Nat.

1st 24 hrs. after shot

Gas Cu. Ft.

Dry Hole

Abandoned

Date

MAR 16 1946

S. J. LEWIS

Scout

Kansas Pool Name Adel
 Map No. KANSAS 33 Sec. 11 Twp. 6 R. 27W

Well No. 4 C. Cramer
Continental Company

COMPLETED

Contractor _____

NE SW NE

F1,2632
SECTION PLAT

_____ Ft. from N. Line
990 Ft. from S. Line
 _____ Ft. from E. Line
990 Ft. from W. Line

		o	

Sheridan County

Location _____

Rig up _____

Drilling and Remarks: _____

Lane 8617
6" @ 8866
Prof Lane.
1000 acid
Pump 9250 ft
382 ft

RECORD

Cased _____ in., _____ ft.
 Sand _____
 Gas _____
 Oil _____
 Total Depth 3868

PRODUCTION

1st 24 hrs. Nat. _____
 1st 24 hrs. after shot _____
 Gas _____ Cu. Ft.
 Dry Hole _____
 Abandoned _____

Date _____

APR 17 1946 19

S. J. LEWIS

Scout