


Section 11 Township 6 Range 27W

Well No. 6 Cramer

Company Continental

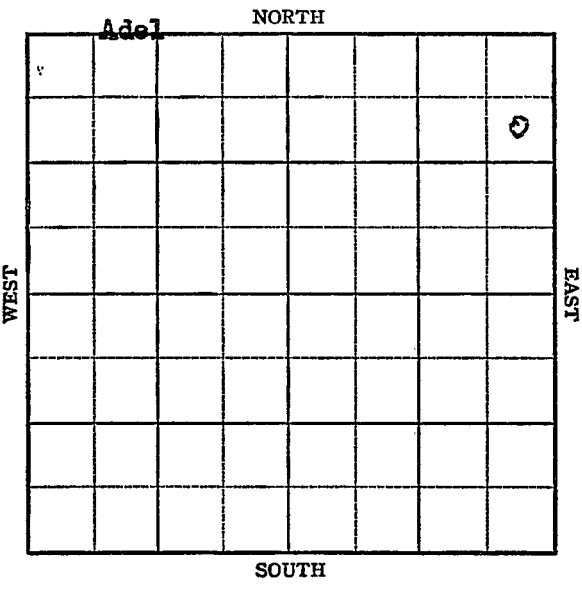



KANSAS Sheridan

Sec. 11 Twp. 6 R. 27W

Well No. #6 Cramer Farm
Continental Company

Adel


990 Ft. from N. Line

Ft. from S. Line

330 Ft. from E. Line

Ft. from W. Line

Sheridan County

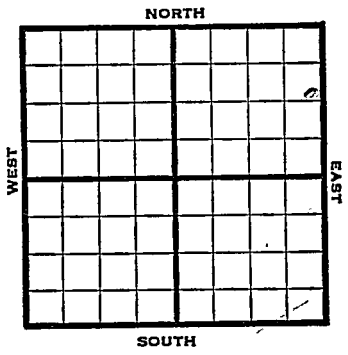

1947 Elev. 2631' **REPORT**

- 9/10 Location
 - 9/17 10" @ 285'
WOC
 - 9/24 Drlg. 3230'
 - 10/1 TD 3870'
6" @ 3869'
RUST
 - 10/8 Lansing 3603'
TD 3820'
 - 10/15 63 shots. 3700-24'
Swab 6 bbls. oil PH IW Ph 6 hrs.
 - 10/21 "
 - 11/5 Lansing 3603'
6" @ 3869'
63 shots 3700-24
Pump 538 oil & 20% W Pot
Gr. 34°
Total Depth 3870'
- COMPLETED**

Map No. _____ Sec. 11 Twp. 6 R. 27W

Well No. 6 Cramer

Continental Company

FIRST REPORT

Contractor _____

SE NE NE

SECTION PLAT

990 Ft. from N. Line

_____ Ft. from S. Line

330 Ft. from E. Line

_____ Ft. from W. Line

Sheridan County

Location X

Rig up _____

Drilling and Remarks:

RECORD

Cased _____ in. _____ ft.

Sand _____

Gas _____

Oil _____

Total Depth _____

PRODUCTION

1st 24 hrs. Nat. _____

1st 24 hrs. after shot _____

Gas _____ Cu. Ft.

Dry Hole _____

Abandoned _____

Date

SEP 10 1947 19

S. J. LEWIS Scout

Adel Pool

Form 26 200 Bks. 10-46 Petrol
Kansas

Map No. 135 Sec. 11 Twp. 6 R. 27W

Well No. 6 Cramer

Continental Company

COMPLETE

Contractor

E. I. 2631

SE NE NE

SECTION PLAT

990 Ft. from N. Line

_____ Ft. from S. Line

330 Ft. from E. Line

_____ Ft. from W. Line

Sheridan County

Location _____

Rig up _____

Drilling and Remarks:

Loc 3603
6" @ 3869
63 sh to 3700-24
Pump 538 oil +
2070 W Pad
34 @ 41

RECORD

Cased _____ in., _____ ft.

Sand _____

Gas _____

Oil _____

Total Depth 3870

PRODUCTION

1st 24 hrs. Nat. _____

1st 24 hrs. after shot _____

Gas _____ Cu. Ft.

Dry Hole _____

Abandoned _____

Date

NOV 5 1947 19

S. J. LEWIS

Scout