


Section 12 Township 6 Range 27W

Well No. 2 Leonard

Company Continental

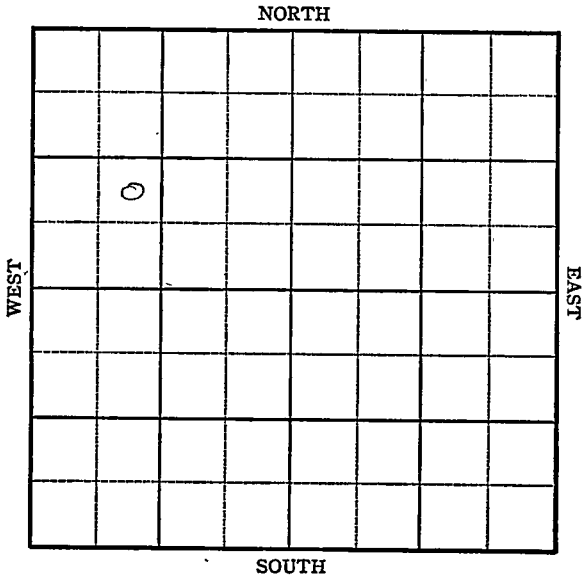

Sec. 12 Twp. 6 R. 27-W


Well No. #2 Leonard Farm
Continental Company

 Ft. from N. Line

990 Ft. from S. Line

 Ft. from E. Line

990 Ft. from W. Line

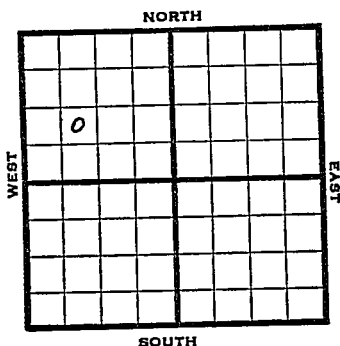

NE SW NW

REPORT

1945

Elev. 2609

- 11/14 RUR
- 11/21 10" @ 240
Drlg. 909'
- 11/28 Drlg. 2765'
- 12/5 Drlg. 3688
- 12/12 TD 3850
6" @ 3849 RUST
- 12/20 21 shots 3684-3709' 1200' water &
200' oil. Squeeze.
- 12/29 37 shots 3810-30'
64 shots 3780-3810
17 shots 3758-66'
42 shots 3716-36'
30 shots 3763-78' 2850' oil 8 hrs.
- 1946
1/10 Lans. 3602- 32 shots 3644-59'
1000 acid. Swab 53 oil per hr 3 hours.
- 1/16 Lans 3602
6" @ 3849
Perf. 1000 acid.
TD 3850
Pump 823 Pot.
Grav. 36.0

COMPLETED

KANSAS

Pool Name AdelMap No. 135 Sec. 12 Twp. 6 R. 27WWell No. 2-Leonard

Continental Company

FIRST REPORT

Contractor

NE SW NW

SECTION PLAT

 Ft. from N. Line990 Ft. from S. Line Ft. from E. Line990 Ft. from W. Line

0			

Sheridan CountyLocation Rig up

Drilling and Remarks:

RUR

RECORD

Cased in., ft.Sand Gas Oil Total Depth

PRODUCTION

1st 24 hrs. Nat. 1st 24 hrs. after shot Gas Cu. Ft.Dry Hole Abandoned

Date

NOV 14 1915 19S. J. LEWIS

Scout

KANSAS Pool Name Adel
 Map No. 122 Sec. 12 Twp. 6 R. 27W

Well No. 2 Leonard

Continental Company

COMPLETED Contractor

NE SW NW

E12609
SECTION PLAT

0			


990 Ft. from S. Line


990 Ft. from W. Line

Sheridan County

Location _____

Rig up _____

Drilling and Remarks:

Leak 3602
6" @ 3874
Ref.
Pump 823 PD
36" Gu.

RECORD

Cased _____ in., _____ ft.

Sand _____

Gas _____

Oil _____

Total Depth 7830

PRODUCTION

1st 24 hrs. Nat. _____

1st 24 hrs. after shot _____

Gas _____ Cu. Ft.

Dry Hole _____

Abandoned _____

Date

JAN 16 1946 19

S. J. LEWIS Scout