


# KANSAS

Section 12 Township 6 Range 27W

Well No. 1 J. E. Leonard

Company Continental

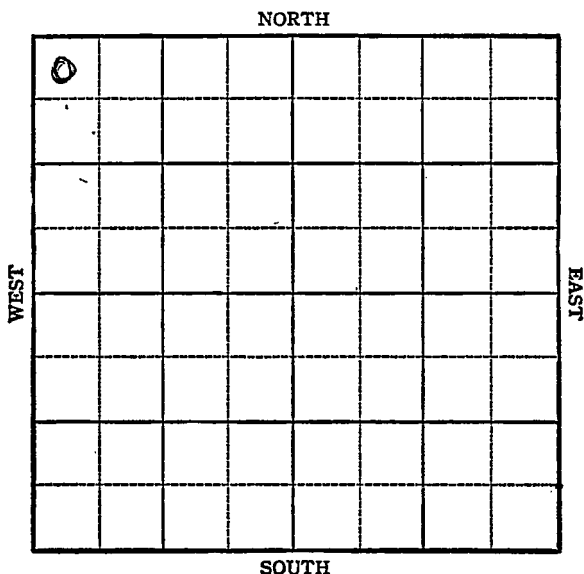

4

**KANSAS**

Sheridan

Sec. 12 Twp. 6 R. 27W

Well No. #1 J E Leonard Farm

Continental Company

Adell


330 Ft. from N. Line

\_\_\_\_\_ Ft. from S. Line

\_\_\_\_\_ Ft. from E. Line

330 Ft. from W. Line

Elev. 2580

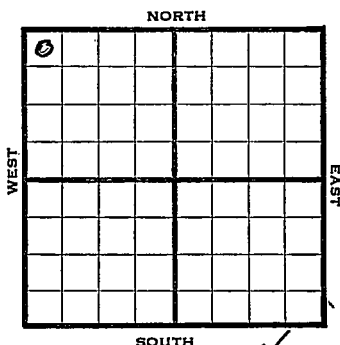

1944

REPORT

8/30

Location

9/8

Drk..

9/13

10" @ 242 Drlg. 1386

9/21

Drlg. 2236

9/28

Drlg. 3507

10/4

Lans 3549

TD 3817

6" @ 3816 RUST

10/11

" " " " "

10/18

72 shots 3754-3800 500 acid swb 5  
oil per hr. 4 hrs.

10/25

Rip csg. 3730-41 1700' oil in 5 hrs

11/2

Rip csg. 3620-27 swb 227 oil in 5 hr

11/8

" " " " " " " " " "

11/16

" " " " " " " " " "

11/24

" " " " " " " " " "

11/29

" " " " " " " " " "

12/6

Lans 3549'  
6" @ 3816'  
Perf. Lans 500 acid  
TD 3817'  
Pump 530 Pot.  
Grav. 31.0

**COMPLETED**

Pool Name Adell

**KANSAS**

 Map No. 13 Sec. 12 Twp. 6 R. 27 W
Well No. 1 J. E. Leonard
Continental Company

**FIRST REPORT** Contractor

NW/C

## SECTION PLAT

0			

330 Ft. from N. Line

\_\_\_\_\_ Ft. from S. Line

\_\_\_\_\_ Ft. from E. Line

330 Ft. from W. LineSheridan CountyLocation X

Rig up \_\_\_\_\_

Drilling and Remarks:

## RECORD

Cased \_\_\_\_\_ in., \_\_\_\_\_ ft.

Sand \_\_\_\_\_

Gas \_\_\_\_\_

Oil \_\_\_\_\_

Total Depth \_\_\_\_\_

## PRODUCTION

1st 24 hrs. Nat. \_\_\_\_\_

1st 24 hrs. after shot \_\_\_\_\_

Gas \_\_\_\_\_ Cu. Ft.

Dry Hole \_\_\_\_\_

Abandoned \_\_\_\_\_

Date

AUG 30 1944 19 \_\_\_\_\_S. J. LEWIS Scout

Pool Name AdellMap No. 135 Sec. 12 Twp. 6 R. 27WWell No. 1 J. E. LeonardContinental CompanyCOMPLETED Contractor

NW/c

## SECTION PLAT

0			

330 Ft. from N. Line

\_\_\_\_\_ Ft. from S. Line

\_\_\_\_\_ Ft. from E. Line

330 Ft. from W. Line

Sheridan

Location \_\_\_\_\_

Rig up \_\_\_\_\_

Drilling and Remarks:


## RECORD

Cased \_\_\_\_\_ in., \_\_\_\_\_ ft.

Sand \_\_\_\_\_

Gas \_\_\_\_\_

Oil \_\_\_\_\_

Total Depth 3812

## PRODUCTION

1st 24 hrs. Nat. \_\_\_\_\_

1st 24 hrs. after shot \_\_\_\_\_

Gas \_\_\_\_\_ Cu. Ft.

Dry Hole \_\_\_\_\_

Abandoned \_\_\_\_\_

Date

DEC 6 1944 19

S. J. LEWIS Scout