


Sheridan

KANSAS

SECTION 12 TOWNSHIP 6S RANGE 27W

WELL NO. #1 Cramer

COMPANY Imperial Oil

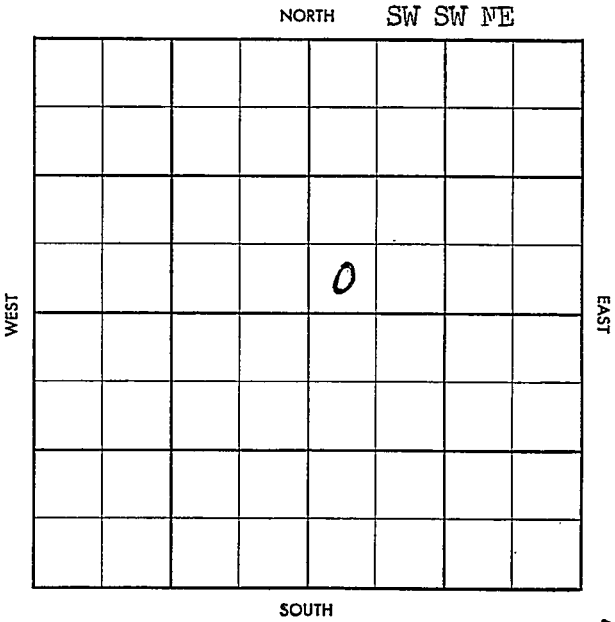

7

Twp. X Pool X
 Co. X Facet X

5-513-B

County Sheridan Elev. 2603 or 2606 RB
 Sec. 12 Twp. 6 Rge. 27W
 Company Imperial Oil
 Farm Name Cramer No. 1

TOPS	DEPTH	LOG	DATUM
Anh.	<u>2162</u>		
Tp.			
H.	<u>3578</u>		
Tr.	<u>3637</u>		
Dg.			
B.L.			
L.	<u>3617</u>		
K.C.			
B.K.C.			
Ce.			
C.			
M.			
M.			
K.			
Mz.			
Mq.			
V.			
S.			
S.			
A.			
R.			
Pf.			
G.			
T.D.	<u>3826</u>		

Loc. in Sec. SW SW NE
 Geol. _____
 Contr. _____
 Co. tools _____
 Pool A dell
 COMPLETE
 APR 30 58

Date Comm. 2-19-58
 Location 55th, 8" 219/150 #3625
MAR 5 58 DST 3637-57 120" 60"
9' M 30' 50 CM 30' MCO BHP
130 DST 3683-3705 60" 10"
M BHP 15 DST 3696-3732 60"
20' M BHP 80 DST 3730-55 60"
20' M BHP 50 DST 3752-85 120" 180' dip
110' 50 CM BHP 390 DST 3781-3826 60"
45' M BHP 80 5" 3826 no log
MAR 12 58 MCT MAR 19 58 28/ 3792-96 (1/2)

Co.
 No.
 Sec.
 T.
 R.

\$ 2 1/2 Bz ph NW 8 hrs 12/3773-76
 A \$ 7 1/2 Bz ph + trw 7 hrs \$ 3 1/2 Bz ph
 NW 10 hrs 14/3661-63 12/3651-53
 A \$ 1 Bz + 3 Bz ph 5 hrs Tbg 3620
 ROCK SQ MAR 26 '58 CD 3670 \$ 1/2 Bz ph
 24 hrs \$ 5 5/10 + 5 g w ph 24 hrs
 PB 3658 9/11 3657-53 \$ 1 1/2 Bz +
 1 1/2 Bz ph 24 hrs CD 3800 POP
 APR 2 '58 APR 9 '58 APR 15 '58 APR 23 '58 W o pot
 APR 30 '58 Phyp 149 Bz pd 1109 w
 w 38°
 Lsg 3651 - 3796

12-6-27W

SW SW W