


Sheridan

Section 12 Township 6 Range 27W

Well No. 5 Leonard

Company Continental

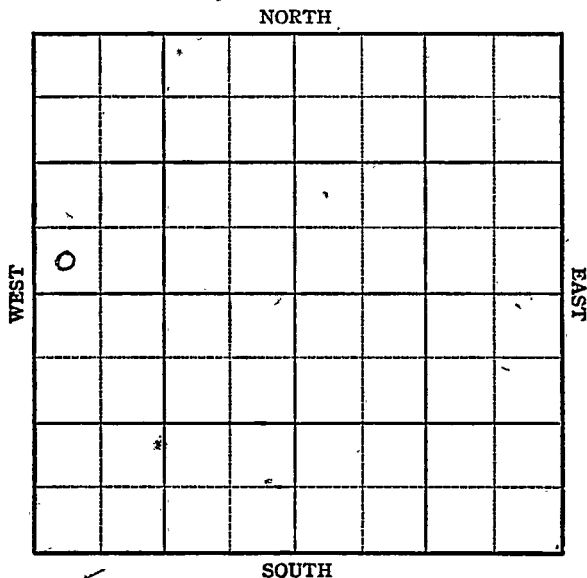

5

KANSAS

Sheridan ✓

Sec. 6 Twp. 6 R. 27-N

Well No. #5 Leonard Farm


Continental Company
Adel

 Ft. from N. Line

330 Ft. from S. Line

 Ft. from E. Line

330 Ft. from W. Line

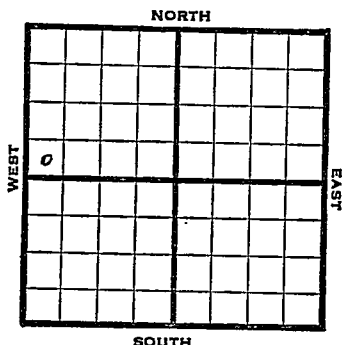

SW NW

1947

Elev. 2649' REPORT

5/14 Location

5/20 Derrick

5/27 10" @ 240'
WOC

6/3 Drlg. 8204'

6/10 Lansing 3619
TD 3870
7" @ 3869'
RUST

6/21 48 shots 3728-48 water
S S O

6/24 500 acid water squeeze
48 shots 3830-48 W
39 " 3813-26
48 " 3756-74 SD

7/1 " " " " "

7/9 Lans. 3619'
7" @ 3869'
Perf. 1000 Acid
Pump 368 Pot 26.0 Gr.
TD 3870'

COMPLETED

Map No. K135 Sec. 12 Twp. 6 R. 27WWell No. 5 LeonardContinental

Company

FIRST REPORT

Contractor

SW NW

SECTION FLAT

 Ft. from N. Line330 Ft. from S. Line Ft. from E. Line330 Ft. from W. Line**Sheridan County**Location XRig up

Drilling and Remarks:

RECORDCased in., ft.Sand Gas Oil Total Depth **PRODUCTION**1st 24 hrs. Nat. 1st 24 hrs. after shot Gas Cu. Ft.Dry Hole Abandoned

Date

MAY 14 1947

19

S. J. LEWIS

Scout

Map No. 135 Sec. 12 Twp. 6 R. 27W

Well No. 5 Leonard

Continental Company

COMPLETE Contractor

SWNW

E1.264?
SECTION PLAT

 Ft. from N. Line

330 Ft. from S. Line

 Ft. from E. Line

330 Ft. from W. Line

Sheridan County

Location

Rig up

Drilling and Remarks:

Loss 8619

7" @ 2869

*Perf
Mooacid*

Pump 368 Bx

260 lbs

RECORD

Cased in., ft.

Sand

Gas

Oil

Total Depth 2870

PRODUCTION

1st 24 hrs. Nat.

1st 24 hrs. after shot

Gas Cu. Ft.

Dry Hole

Abandoned

Date

JUL 9 1947 19 S. J. LEWIS Scout