

Section 12 Township 6 Range 27W

Well No. #6 Leonard

Company Continental

Adel

NORTH

	0						

WEST

EAST

SOUTH

4

Sec. 12 KANSAS Twp. 6 R. 27W

Well No. #6 Leonard Farm
Continental Company
Adel


990 Ft. from N. Line

_____ Ft. from S. Line

_____ Ft. from E. Line

990 Ft. from W. Line

SE NW NW

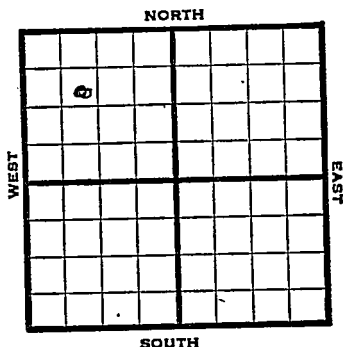

1947

Elev. 2595' REPORT

10/22

Derrick

10/29

10" @ 305'
Drlg. 2436'

11/5

Drlg. 3680'

11/12

Lansing 3579'
TD 3858'
6" @ 3849'
RUST

11/19

42 shots 3685-3701
500 Acid swb 14 W PH, 9 hrs
Squeeze

11/25

38 shots. 3716-30'
38 shots. 3772-84' water 1000 acid
Swb. 25 bbls. WPH squeeze.

12/3

24 shots 3579-3588'

12/10

Lansing 3579'
6" @ 3849'
Perf. 2500 acid
Total Depth 3850'

ABANDONED

Form 26 200 Bks. 10-46 Petrol
Kansas Adel

Map No. _____ Sec. 12 Twp. 6 R. 27W

Well No. 6 Leonard
Continental Company

FIRST REPORT Contractor

SE NW NW

990 Ft. from N. Line

_____ Ft. from S. Line

_____ Ft. from E. Line

990 Ft. from W. Line

SECTION PLAT

o			

Sheridan County

Location _____

Rig up _____

Drilling and Remarks:
Derrick

RECORD

Cased _____ in., _____ ft.

Sand _____

Gas _____

Oil _____

Total Depth _____

PRODUCTION

1st 24 hrs. Nat. _____

1st 24 hrs. after shot _____

Gas _____ Cu. Ft.

Dry Hole _____

Abandoned _____

Date

OCT 22 1947 19

S. J. LEWIS

Scout

Form 26 200 Bks. 10-46 Petrol
Kansas

Adel Pool

Map No. 135 Sec. 12 Twp. 6 R. 27W

Well No. 6 Leonard

Continental Company

ABANDONED Contractor

SE NW NW

E 12595
SECTION PLAT

990 Ft. from N. Line

_____ Ft. from S. Line

_____ Ft. from E. Line

990 Ft. from W. Line

Sheridan County

Location _____

Rig up _____

Drilling and Remarks:

Lease 3579

6" 08849

Prof. 2000000000

RECORD

Cased _____ in., _____ ft.

Sand _____

Gas _____

Oil _____

Total Depth 35.30

PRODUCTION

1st 24 hrs. Nat. _____

1st 24 hrs. after shot _____

Gas _____ Cu. Ft.

Dry Hole _____

Abandoned _____

Date

DEC 10 1947 19

S. J. LEWIS

Scout