
Sheridan **KANSAS**

SECTION 12 TOWNSHIP 6S RANGE 27W

WELL NO. #7 J.E. Leonard

COMPANY Continental Oil

NORTH SE NE SW

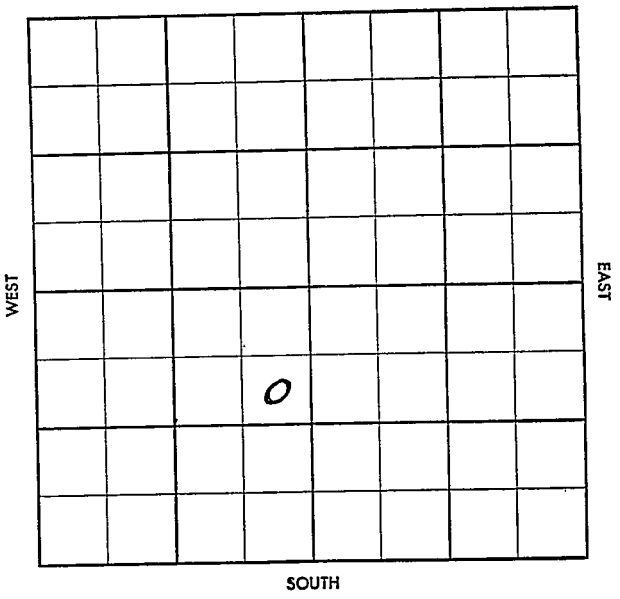

11

FORM 504-3 SUNRAY

33

S-513-B

County Sheridan Elev.

Sec. 12 Twp. 6 Rge. 27W

Company Continental Oil

Farm Name J. E. Leonard No. 7

TOPS	DEPTH	LOG	DATUM
Anh.			
Tp.			
H.			
Tr.			
Dg.			
B.L.			
L.			
K.C.			
B.K.C.			
Ce.			
C.			
M.			
M.			
K.			
Mz.			
Mq.			
V.			
S.			
S.			
A.			
R.			
Pf.			
G.			
T.D.			

Loc. in Sec. SE NE SW

Geol.

Contr. E. Wakefield

Pool Adell

FEB 19 '38
FIRST REPORT

Date Comm.

Location

Co. Lse. No. Sec. T. R.

Twp. Pool

Co. V Facet

S-513-B

County Sheridan Elev. 2624 or 2627 RB

Sec. 12 Twp. 6 Rge. 27W

Company Continental Oil

Farm Name J. E. Leonard No. 7

TOPS	DEPTH	LOG	DATUM
Anh.			
Tp.			
H.	3576	3596	
Tr.	3620	3620	
Dg.			
B.L.			
L.	3639	3639	
K.C.			
B.K.C.	3936	3844	
Ce.			
C.			
M.			
M. K.			
Mz.			
Mq.			
V.			
S.			
S.			
A.			
R.			
Pf.			
G.			
T.D.	3890		

Loc. in Sec. SE NE SW

Geol.

Contr. E. Wakefield

Pool Adel

APR 23 '58

COMPLETE

Date Comm. 2-22-58

Location FEB 26 '58 8" 200/175 ø 1800

MAR 5 '58 ø3478 MAR 12 '58 cmd 3618-50

rec 36' cmd 3650-78 rec 28'

cmd 3678-92 14' rec DST 3662-92

60" 200' gip 25' free oil 70' HOCM 10'

WM FP 0-40 BHP 420-290/45"

cmd 3718-46 28' rec DST 3720-46

failed Log MAR 19 '58 5½ 3879/200

WOCT MAR 26 '58 CO 3843 8/3812 (2)

FORM 513-1 SUNRAY

5 ¢ Ld + 73 B New oil NW 24hrs
5 ¢ Ld + ¢ 120 B new oil NW
24hrs ¢ 3 B Oph NW 6hrs
¢ 3791 Pkr ¢ 101 BO NW 14hrs
¢ 5 Boph NW 5hrs 2 APR 2 '58
¢ 161 BLd O + 2½ B new o new
10hrs ¢ 52 BO + 5½ B SW 6½ hrs
CO 38 #3 ¢ 46 BO + 17 BW
17hrs ¢ 17.88 BO + 3 OW 3hrs
Tbg POP APR 9 '58 APR 16 '58 45 BO +
APR 23 '58 Phy p 92 BO pd 37° gr + 14
Bo pd
Lsg 3791 - 3812

12-6-27W