
Sheridan KANSAS

SECTION 12 TOWNSHIP 6S RANGE 27W

WELL NO. #6 Schoen

COMPANY Imperial Oil Co.

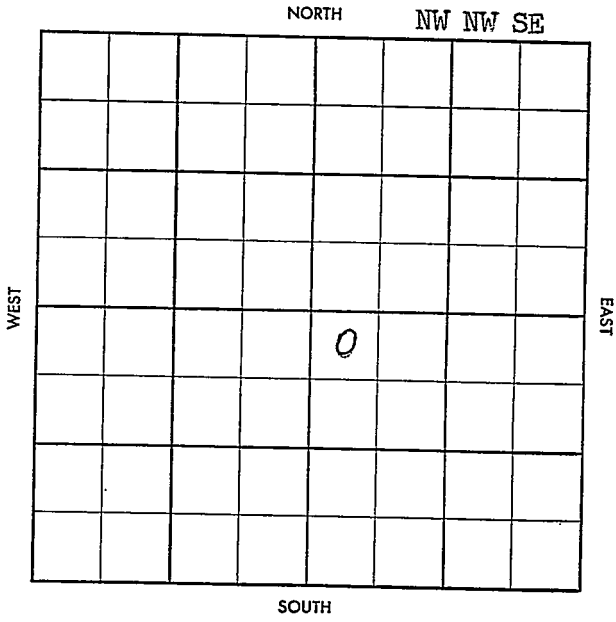

10

FORM 504-3 SUNRAY

33

S-513-B

Co.

County Sheridan Elev.

Sec. 12 Twp. 6 Rge. 27W

Company Imperial Oil Co.

Farm Name Schoen No. 6

TOPS	DEPTH	LOG	DATUM
Anh.			
Tp.			
H.			
Tr.			
Dg.			
B. L.			
L.			
K.C.			
B.K.C.			
Ce.			
C.			
M.			
M.			
K.			
Mz.			
Mq.			
V.			
S.			
S.			
A.			
R.			
Pf.			
G.			
T.D.			

Loc. in Sec. NW NW SE

Geol.

Contr. Co. Tools #1

Lse.

Pool Adell

FEB 5 58
FIRST REPORT


No.

Sec.

T.

R.

Date Comm. WOR

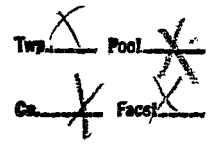

S-513-B

Co.

County Sheridan Elev. 2608DF 2611RB

Sec. 12 Twp. 6 Rge. 27W

Company Imperial Oil Co.

Farm Name Schoen No. 6

TOPS	DEPTH	LOG	DATUM
Anh.	2164		
Tp.	3580		
H.			
Tr.			
Dg.			
B. L.	3621		
L.			
K.C.			
B.K.C.			
Ce.			
C.			
M.			
M.			
K.			
Mz.			
Mq.			
V.			
S.			
S.			
A.			
R.			
Pf.			
G.			
T.D.	3828		

Loc. in Sec. NW NW SE

Geol.

Contr. Co. Tools #1

Lse.

Pool Adell

COMPLETE

0

APR 30 '58

No.

Sec.

T.

R.

Date Comm. 2-8-58

WOR FEB 12 '58 8" 220/16. ₿2150 FEB 10 --

DST 3638-58 120" 1020' fig inc 160' oil 90' MO 30' V HOCM BHP 270 ₿3760 FEB 26 '58 Log 5½" 3828/125 WOC 1 MAR 5 '58 MAR 12 '58

CO 23/3798-3802 21/3778-81

(3) $ 1½ BO 1hr $ 1 BOph NW 8 hrs 16/3744-48 (½) $ 1½ BOph NW 8 hrs MAR 19 '58

$ 1 BOph NW 6 hrs 12/3711-14

1½ $ 1 BO ph NW NT

FORM 813-1 SUNRAY

7/3665-66 14/3654-56 /2

3 4/4 Boph NW 12 hrs (4) $7 1/2 Boph

NW 8 hrs pd p MAR 26 '58 APR 2 '58 APR 9 '58 APR 16 '58

APR 23 '58 APR 30 '58 Phy P 177 BO pd

7 30/0 lw gr 38° Lsg

3654 - 3802

12-6-27W nw-nw-se