


Section 12 Township 6 Range 18-W

Well No. #2, Faubian

Company Alkay Oil Company

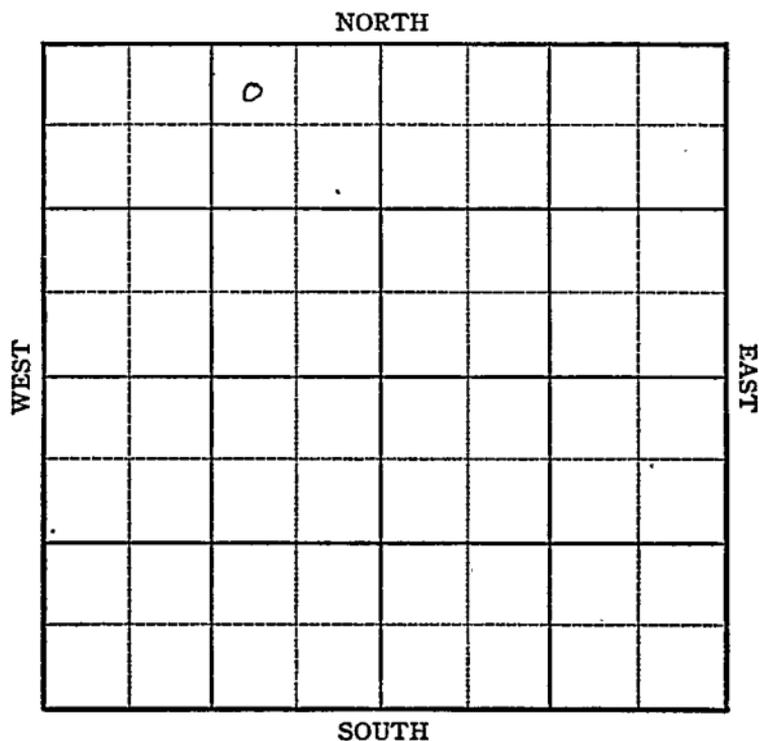

3

KANSAS

Sec. 12 Twp. 6-S R. 18-W

Well No. #2 Faubian Farm

Alkay Oil Company

Company


330' Ft. from N. Line

Ft. from S. Line

990' Ft. from E. Line

Ft. from W. Line

NW NE NW

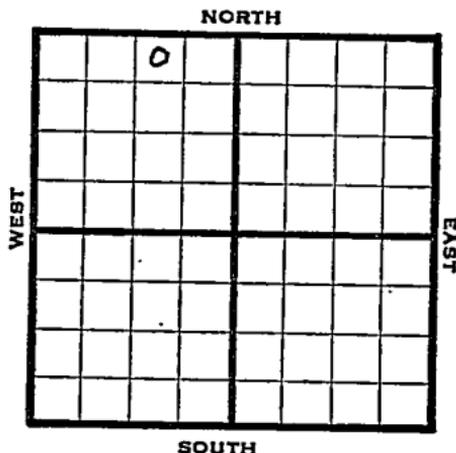

1946 1902 REPORT

9/5	10" @ 3400	drlg.	1830
9/10	Topeka	2829	
	Lans	3057	
	Drlg	3084'	
9/18	TD	3262	
	7" @ 3156	RUST	
9/24	"	"	"
10/1	"	"	"
10/8	"	"	"
10/12	130' W plus 70'	oil	
	SD		
10/22	"	"	"
10/29	3000 acid	no help	
11/6	119' of 5"	perf liner @ 3262'	
11/12	"	"	"
11/20	"	"	"
11/27	"	"	"
12/3	"	"	"
12/10	"	"	"
12/17	"	"	"
1947			
1/4	119' of 5"	Perf liner @	
	3262'		
1/8	"	"	"
1/15	"	"	"

OVER

1/21 119' of 5" .  
Perf Liner @ 3262'

1/30 " " "

2/12 Topeka 2829'  
Lans 3057'  
7" @ 3156  
6000 Acid  
Pump 15 Oil & 140 W Pot  
Grav. 22  
TD 3262'

**COMPLETED**

KANSAS Pool Name Faubian  
 Kansas  
 Map No. 7.32 Sec. 12 Twp. 6 R. 18W

Well No. 2 Faubian

Alkay Oil Company

**FIRST REPORT**

Contractor \_\_\_\_\_

NW NE NW

**SECTION PLAT**

330 Ft. from N. Line  
 \_\_\_\_\_ Ft. from S. Line  
990 Ft. from E. Line  
 \_\_\_\_\_ Ft. from W. Line

	o		

Rooks County

Location \_\_\_\_\_  
 Rig up \_\_\_\_\_  
 Drilling and Remarks:  
10" @ 1400  
drlg. 1830

**RECORD**

Cased \_\_\_\_\_ in., \_\_\_\_\_ ft.  
 Sand \_\_\_\_\_  
 Gas \_\_\_\_\_  
 Oil \_\_\_\_\_  
 Total Depth \_\_\_\_\_

**PRODUCTION**

1st 24 hrs. Nat. \_\_\_\_\_  
 1st 24 hrs. after shot \_\_\_\_\_  
 Gas \_\_\_\_\_ Cu. Ft.  
 Dry Hole \_\_\_\_\_  
 Abandoned \_\_\_\_\_

Date  
SEP 5 1946 19

S. J. LEWIS Scout

KANSAS

Faubian Pool

Kansas

Map No. 132 Sec. 12 Twp. 6 R. 18W

Well No. 2 Faubian

Alkay Oil Company

**COMPLETE** Contractor

NW NE NW

*E. 1902*  
SECTION PLAT

330 Ft. from N. Line

\_\_\_\_\_ Ft. from S. Line

990 Ft. from E. Line

\_\_\_\_\_ Ft. from W. Line

	6		

Rooks County

RECORD

Location \_\_\_\_\_

Cased \_\_\_\_\_ in., \_\_\_\_\_ ft.

Rig up \_\_\_\_\_

Sand \_\_\_\_\_

Drilling and Remarks:

Gas \_\_\_\_\_

Oil \_\_\_\_\_

Total Depth 3262

*Topka 282'*

*Lams 305'*

*7" @ 95'*

*6000 casing*

*Pump 15' oil + 140' W*

*BY*

*22 2/22*

PRODUCTION

1st 24 hrs. Nat. \_\_\_\_\_

1st 24 hrs. after shot \_\_\_\_\_

Gas \_\_\_\_\_ Cu. Ft.

Dry Hole \_\_\_\_\_

Abandoned \_\_\_\_\_

Date

FEB 12 1947 19

S. J. LEWIS Scout