


Section 12 Township 6 Range 18 W

Well No. #1 Hindman - Shaw

Company Hindman & Shaw et al

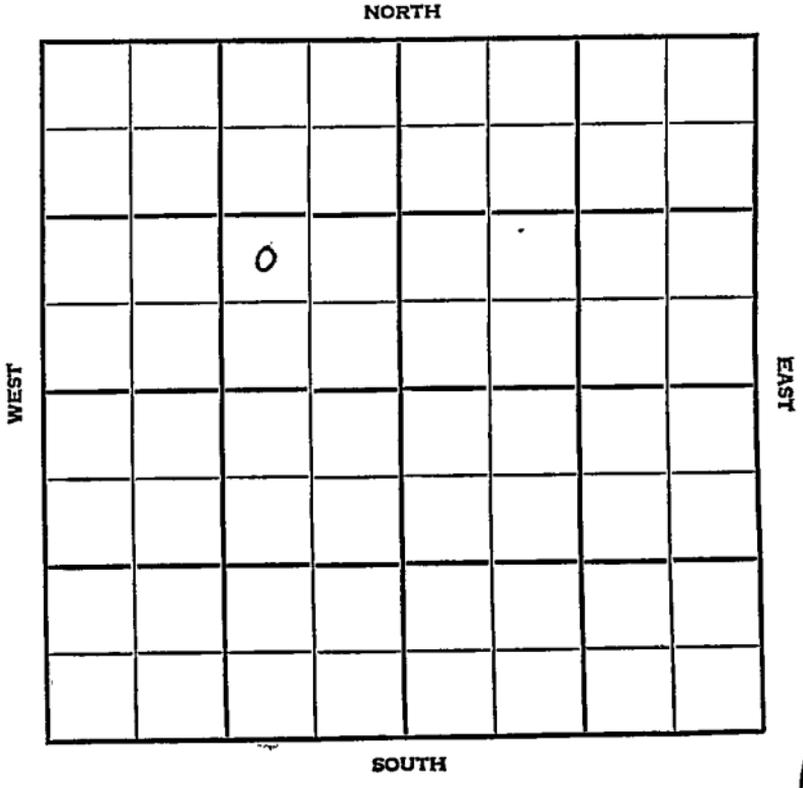

Rooks

KANSAS


SEC.	TWP.	R..
12	6	18W

WELL NO. #1 Hindman - Shaw

COMPANY Hindman & Shaw et al FARM

CONTRACTOR Transit
Faubin

_____ Ft. from N. Line
 _____ Ft. from S. Line
 _____ Ft. from E. Line
 _____ Ft. from W. Line

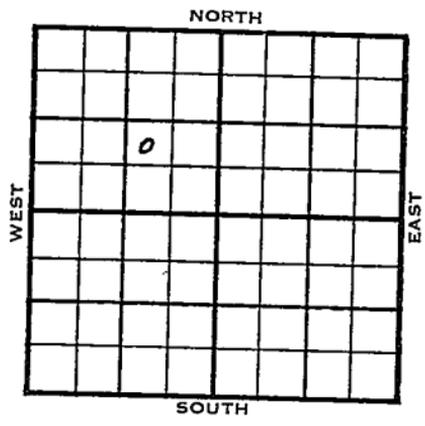

NW SE NW

1955	ELEVATION 1923'	REPORT
------	--------------------	--------

10/12 Comm 10-3-55
 8" @ 212/150
 Anhy 1340
 Tp 2876
 Drlg 3055

10/19 Comm 10-3-55
 8" @ 212/150
 Anh 1340
 Tp 2876
 H 3079
 Tr 3106
 L 3123
 BKC 3354
 TD 3475
 DST 3164-3215 open 50 min. Rec 50'
 mud 40/20" D & A

ABANDONED

County Rooks Elev. 1923 Co.
 Sec. 12 Twp. 6 Rge. 18W
 Company Hindman & Shaw et al.
 Farm Name Hindman - Shaw No. 1

TOPS	DEPTH	LOG	DATUM
Anh.	131.0		
Ip.	287.6		
H.			
Tr.			
Dg.			
Bl.			
L.			
K.C.			
B.K.C.			
Ce.			
C.			
M.			
M.			
K.			
Mz.			
Mo.			
V.			
S.			
S.			
A.			
R.			
Pe.			
G.			
TD.			

Loc. in Sec. NW SE NW

Geol. _____

Contr. _____

Transit

Pool _____

Faubin

OCT 12 '58
 10
FIRST REPORT

Date Comm. 10-3-55
8" @ 212/150 drlg. 3055



Co.
Lse.
No.
Sec.
T.
R.

County Rooks Elev. 1923
 Sec. 12 Twp. 6 Rge. 18W
 Company Hindman & Shaw etal.
 FarmName Hindman - Shaw No. 1

TOPS	DEPTH	LOG	DATUM
Anh.	<u>1340</u>		
Tp.	<u>2876</u>		<u>953</u>
H.	<u>3079</u>		<u>1156</u>
Tr.	<u>3106</u>		<u>1183</u>
Dg.			
Bl.			
L.	<u>3123</u>		<u>1200</u>
K.C.			
B.K.C.	<u>3354</u>		<u>1431</u>
Ce.			
C.			
M.			
M.			
K.			
Mz.			
Mq.			
V.			
S.			
S.			
A.			
R.			
PE.			
G.			
T.D.	<u>3475</u>		

Loc. in Sec. NW SE NW
 Geol. _____
 Contr. _____
 Transit _____
 Pool _____
 Faubin _____



Date Comm. 10-3-55 : OCT 19 1955
8" @ 212/150 DST 3164-3215 open
50 min. Rec. 50' mud 10/20 "

D & A.

Co.
 Lse.
 No.
 Sec.
 T.
 R.