




*Rooks*

Map No. **KANSAS** Sec. **12** Twp. **6** R. **18 W.**

Well No. **1 - Row** Farm **Gillespie & Sons** Company

**330** Ft. from N. Line  
 \_\_\_\_\_ Ft. from S. Line  
**330** Ft. from E. Line  
 \_\_\_\_\_ Ft. from W. Line  
 Elev. **1883**

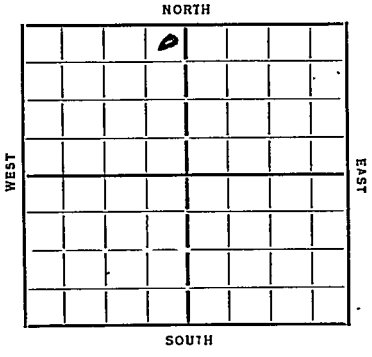

Date	REPORT
1935	
6/26	Location
7/31	7/11 - 7/18
8/8	Cellar
8/15	
8/22	April
8/29	75 1/2 20 12 1/2 750
9/6	870 WR 12"
10/3	slg 1505
10/10	15060 fsg 10"
11/1	Cement 1300 slg plugs
11/7	fsg
11/14	
11/21	slg 1800
11/29	" 2050 8" 1521
12/6	TD 2295 WR 8"
12/13	slg 2520 8" 2294
12/19	HEW 2590 - 2600 WR 8"
1/2/26	
1/2/36	slg 2685 8" 2635
1/10	Shows of Oil 2835, 2890, 2955-60, Top Topok 2820 Top KC 3036 TD 3037 Run 6" <b>OVER</b>

1/17 6" 3037 TD 3158  
175' Oil 3128-31.

1/24 Rung liner

1/31 TD 3161 126' 5" liner  
2500' Oil Will acidize

2/7 pumped 60 Bbls oil 9 hrs.  
4000 acid  
ate pipe seat off & had HFW  
Resetting pipe

2/14 TD 3161 PB 3118  
w 126" 3050

2/21 6" 3121 Acidizing

2/28 6" 3108 Drilled plug  
2000' Oil pumped 6 Bbls per hr  
4000 acid TD 3149  
T Lams 3024 (Cow)

3/4 KC 3024  
TD 3149  
306 Bbls 22 hrs.

COMPLETED

KANSAS

Map No. 132 Sec. 12 Twp. 6 R. 18<sup>W</sup>

Well No. 1 - Row

Gillespie & Sons Company

Contractor

COMPLETE

SECTION PLAT

330 Ft. from N. Line

..... Ft. from S. Line

330 Ft. from E. Line

..... Ft. from W. Line

		9	

Location.....

Rig up.....

Drilling and Remarks:

306 bbls.  
22 hrs

RECORD

Cased..... in., ..... ft.

Sand 17C 3024

Gas.....

Oil.....

Total Depth 3149

PRODUCTION

1st 24 hrs. Nat.....

1st 24 hrs. after shot.....

Gas..... Cu. Ft.

Dry Hole.....

Abandoned.....

Date

3-4-36 192.....

DRY - 1 ANNECHRECK

Scout

Map No. 132 Sec. 12 Twp. 6 R. 18W

Well No. 1 Row

Gillespie & Sons Company  
Contractor

SECTION PLAT

	0		

530 Ft. from N. Line

..... Ft. from S. Line

230 Ft. from E. Line

..... Ft. from W. Line

FIRST REPORTS

Location ✓

Rig up .....

Drilling and Remarks:

RECORD

Cased ..... in., ..... ft.

Sand .....

Gas .....

Oil .....

Total Depth .....

PRODUCTION

1st 24 hrs. Nat. ....

1st 24 hrs. after shot. ....

Gas ..... Cu. Ft.

Dry Hole .....

Abandoned .....

Date 6/26/35  
~~7/26/35~~

ORVAL MANNSCHECK

..... 192 ..... Scout