



Sheridan

KANSAS ✓

Sec. 13 Twp. 6 R. 27 W

Well No. # 1 Muir Farm

Shields Company

Shields Contractor


330 Ft. from N. Line

\_\_\_\_\_ Ft. from S. Line

990 Ft. from E. Line

\_\_\_\_\_ Ft. from W. Line

NW NE NW

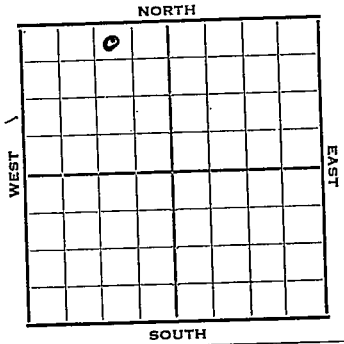

1952

Elev. 2613'

REPORT

7/16

Location

7/23

MI

7/30

8" @ 240

Anhy 2265' Drlg. 2765'

8/6

Spud 7-22-52

D & A TD 4010'

8" @ 240 Anhy 2265' Top 3391'

Heeb 3600' KC 3640' Marm. 3990'

TD 4010' D & A

**ABANDONED**

County **Sheridan** State **Kansas**

Sec. **13** (Blk.) **6** (Sur. Rge.) **27W** Map No.

Operator **Shields**

Well No. **1** Farm **Muir**

Elev. \_\_\_\_\_ Location **NW NE NW**

	o				

**330** Ft. From **N** Line **NW**

**990** Ft. From **E** Line **Quarter**

Ist. Report **JUL 16 1952**

Completion \_\_\_\_\_

Remarks \_\_\_\_\_

**Shields - Contr.**

Spudding Date \_\_\_\_\_

Drig. Data \_\_\_\_\_

**Location**

**J. G. MCGHEE**

County Sheridan State Kansas

Sec. 13 (Blk. 6) (Sur. Rge.) 27W Map No.

Operator Shields

Well No. 1 Farm Muir

Elev. 2613 Location NW NE NW

	0				

330 Ft. From N Line NW

990 Ft. From E Line Quarter

1st. Report

Completion AUG 6 1952

Remarks

Shields - Contr.

Spudding Date 7-22-52

Drlg. Data D & A TD 4010

8" @ 240 Anhy 2265 Top. 3391

Heeb. 3600 KC 3640 Marm. 3990

TD 4010

D & A