


Section 13 Township 6 Range 26 W

Well No. # 1 Ward

Company Empire Drlg.

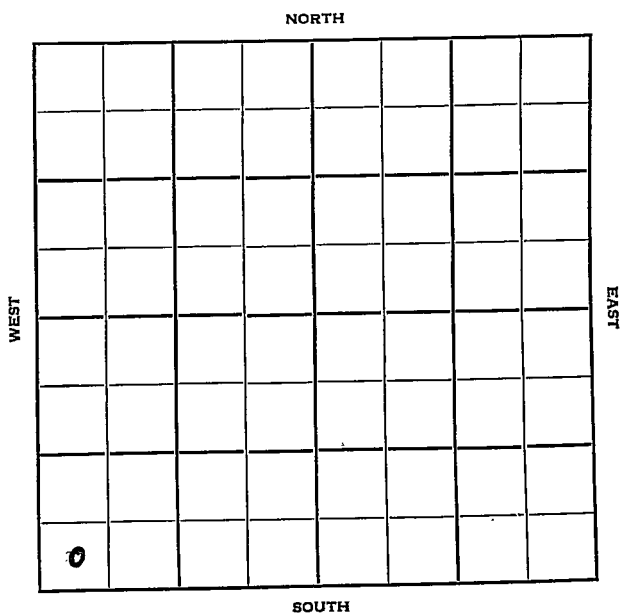

13



Sec. 13 Twp. 6 R. 26W

Well No. #1 Ward Farm

Empire Drlg. Company

Empire -Contr. Contractor

Wildcat


 Ft. from N. Line

330' Ft. from S. Line

 Ft. from E. Line

330' Ft. from W. Line

SW SW SW

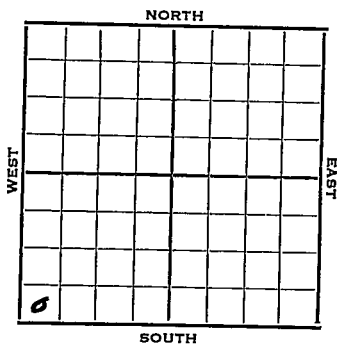

1952 Elev. 2612' REPORT

9/17 Location

9/24 "

10/7 "

10/15 Spud 9-30-52
D&A TD 4248'
8" @ 324'

Anhy 2205 Top. 3522

Heeb. 3677 Tor. 3698

KC 3710 B KC 3908

Cong. 4151 Arb. 4197

TD 4248' D&A

ABANDONED

County Sheridan State Kansas

Sec. **13** (Blk. Twp.) **6** (Sur. Rge.) **26N** Map No.

Operator Empire D.Lg.

Well No. **1** Farm **Herd**

Elev.	Location	SW	SW	SW
-------	----------	----	----	----

0 FIRST REPORT

330 Ft. From S Line SW

330 Ft. From Line Quarter

1st. Report SEP 17 1952

Completion _____

Remarks

Empire - Contr.

Spudding Date _____

Drig. Data **Wildcat**

Location

J. G. McGEHEE

