


Section 15 Township 6 Range 29 W

Well No. # 1 Neff "B"

Company Westpan-Hydrocarbon

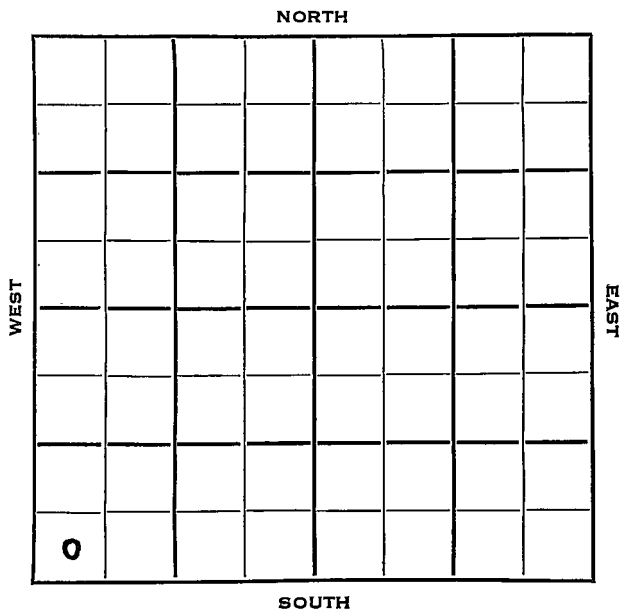

13

Sheridan KANSAS

SEC.	TWP.	R.	
15	6	29 W	✓

WELL NO. # 1 Neff "B" FARM

COMPANY Westpan-Hydrocarbon

CONTRACTOR

~~W&X~~ Wessell Pool


_____ Ft. from N. Line

330 _____ Ft. from S. Line

_____ Ft. from E. Line

330 _____ Ft. from W. Line

SW SW SW

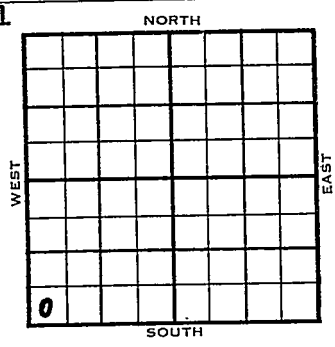

1953	ELEVATION	REPORT
	2793'	

11/24 Spud 11-22-53
8" @ 259 WOC

1954
4/14 Spud 11-22-53
Oil Well
TD 4120'
8" @ 259'
Heeb 3879', Tor 3906', Lans 3920'
Wyandotte 3987',
DST 3973'-4005' rec 8' Mud 480#
TD 4120'
5" @ 4120'
Winterset 4078'
CO to 4075'
1/ 4064 CO to 4080'
20/ 4073'-78' B/ 2 boph
Pump 25 BOPD 1000 A Comp 72bopd

COMPLETED

