


Section 15 Township 6 Range 22W

Well No. #1 Rush

Company Weeder Supply

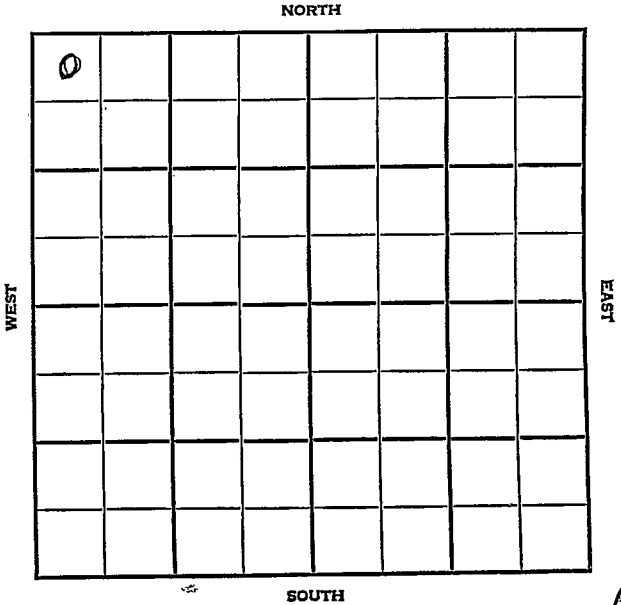

4

Rig Stacked

FORM 313 SUNRAY

County Graham Elev. 2333 KB
 Sec. 15 Twp. 6 Rge. 22W 2330 D7
 Company Veeder Supply
 Farm Name Rush No. 1

TOPS	DEPTH	LOG	DATUM
Anh.	1981		
Tp.	3360	3357	
H.	3540	3541	
Tr.	3564	3564	
Dg.			
Bl.			
L.	3581	3583	
K.C.	3774	3772	
B.K.C.			
Ce.			
C. <u>sdg LI</u>	3818	3814	
M.			
K.			
Mz.			
Mo.			
V.			
S.			
A.	3867	3870	
R.			
PE.			
G.			
TD.	3900		

Loc. in Sec. NW NW NW
 Geol. Thin Lenses
 Contr. Co. Tools
 Pool Wildcat

DEC 5 '56
ABANDONED

Date Comm. 11-21-56
 8 5/8" 225, Drgl. 3130 DEC 5 '56 X Elev.
 TP. 3360 DST. 3487-3510 net 1hr
 nec 350' SW "FP 0-70 BHP 1220/20
 H6 3540 TR 3564 Lsg Ke 3581 DST
 3605-70 net 1hr nec 950' MSW
 FP 90-510 BHP 1170/20" DST 3782
 -80' net 45" nec 20' Md + 5' OCM
 (Trace Free oil) FPO BHP 1000/20"
 BKC. 3774 c9-sdg-LI 3818 Arb 3867 RTP
 3900 Log D & R LOG TONS