

FORM 51

Mitchell

MISSOURI

SAS

Section 15 Township 6 Range 9W


Well No. #1 Theissen

Company National Assoc. Petroleum

NORTH

WEST

EAST

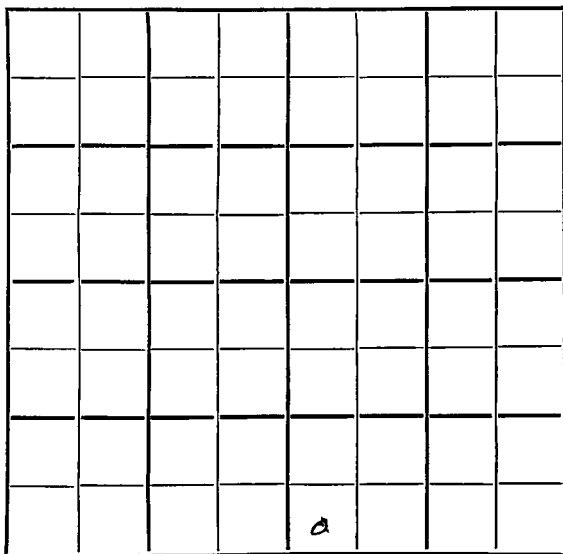

SOUTH

15

Mitchell

KANSAS

Sec. 15 Twp. 6 R. 9 WWell No. # 1 Theissen FarmNational Assoc. Pet. Company

Contractor

Wildcat

Ft. from N. Line

330


Ft. from S. Line

Ft. from E. Line

330

Ft. from W. Line

SW SW SE

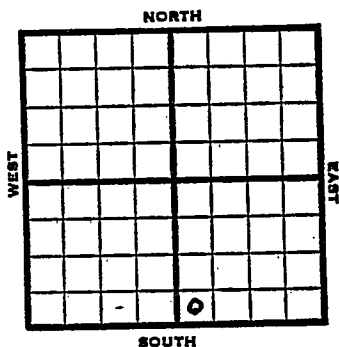

1953

Elev. 1436' REPORT

2/4

Spud 1-29-53

10" @ 400 8" @ 921

2/12

NR

2/19

Drlg. 3900'

2/26

D & A

3/12

"

3/18

Spud 1-29-53

10" @ 400'

8" @ 921


TD 3960

D&A

ABANDONED

J. G. McGEHEE

County Mitchell State Kansas
 Sec. 15 (Blk.) 6 (Sur.) 9W Map No.
 Operator National Assoc. Pet.
 Well No. 1 Farm Theissen
 Elev. 1436 Location SW SW SE

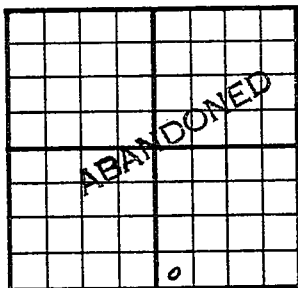

330 Ft. From S Line SE
330 Ft. From W Line Quarter

1st. Report
Completion MAR 18 1953
Remarks Wildcat

Spudding Date 1-29-53

Drig. Data

10" @ 400 8" @ 921 TD 3960

D & A

J. G. McGEHEE