


Section 16 Township 6 Range 29 W

Well No. # 1 Brantley

Company Sauvage & Dunn

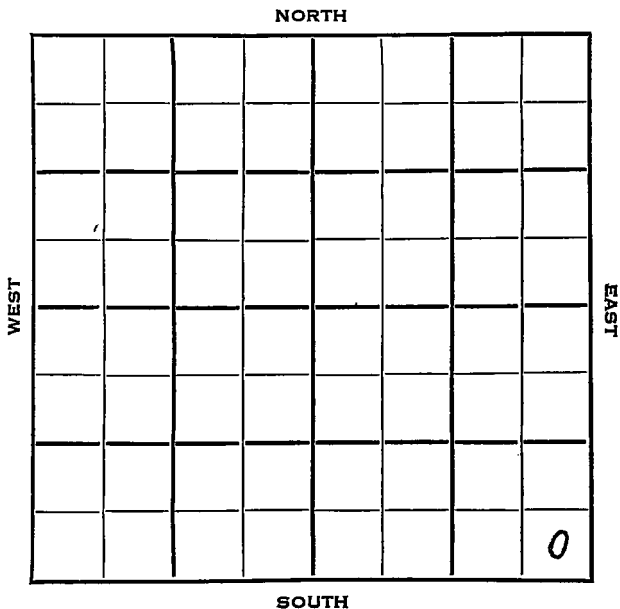

16

Sheridan

KANSAS

SEC. 16	TWP. 6	R. 29W ✓
---------	--------	----------

WELL NO. #1 Brantley

COMPANY Sauvage & Dunn FARM

CONTRACTOR Sauvage & Dunn


Wildcat.

_____ Ft. from N. Line

330 _____ Ft. from S. Line

330 _____ Ft. from E. Line

_____ Ft. from W. Line

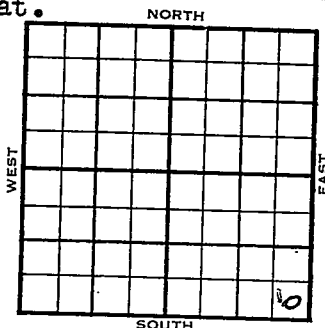

SE SE SE

1953	ELEVATION	REPORT
	2799'	

10/21	Spud 10-13-53 8" @ 453' Drlg 3360'
10/28	Top 3697' Heeb 3887' Lans 3927' SO 4081-86' DST 4081-88, 1½ hr, 830' hly O & GCM 1048# RTD 4115' Schl 5" @ 4114'
11/4	NR
11/11	16/4081-85 2 BOPH 24 hrs.
11/18	NR
12/9	NR
12/16	"
1954	NR
1/20	NR
2/10	Spud 10-13-53 Oil well TD 4115 8" @ 453 Top 3697 Heeb 3887 Lans. 3927 DST 4081-88 open 1½ hr, rec 830' HO & GCM 1048# TD 4115 5" @ 4114 16/4081-85 2 BOPH 24 hr. Comp. 80 BOPD

COMPLETED

