


Section 16 Township 6 Range 29W

Well No. #2 Brantley

Company Sauvage-Dunn

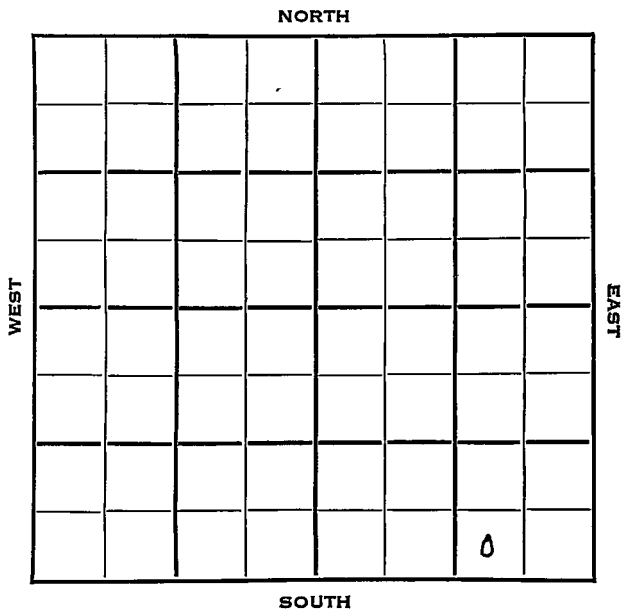

16

Sheridan

KANSAS

SEC.	TWP.	R.
16	6	29W ✓

WELL NO. #2 Brantley FARM

COMPANY Sauvage-Dunn

CONTRACTOR Co. Tools.


Wessel Pool

_____ Ft. from N. Line

330 _____ Ft. from S. Line

990 _____ Ft. from E. Line

_____ Ft. from W. Line

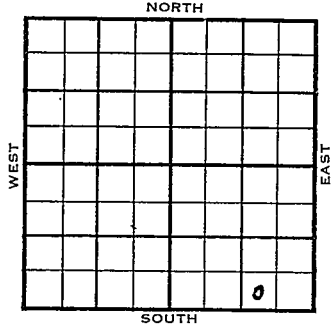

SW SE SE

	ELEVATION	REPORT
1954	2811'	

3/31 Spud 3-27-54
Drlg 1600'

4/7 8" @ 357 w/135 Heeb 3902' Tor 3930
Lans. 3944
Drlg. 4027'

4/14 "

5/19 Spud 3-27-54 Oil well TD 4135
8" @ 357 Heeb 3902 Tor 3930
Lans. 3944 TD 4135' 5" @ 4135
DST 4096-4105 open 1 hr rec 360' gas
60' clean oil, 82' muddy oil 1030#
G0 to 4119 16/4109-10 60/4086-
4102 S/1 BOPH 1000 A S/20 BOPH
3 hr. 14 BOPH 7 hr.
Comp. 96 BOPD

COMPLETED

