

~~PLATS~~ **SAS**

- Graham County

Section 17 Township 6 Range 24W

Well No. #1 T. E. Logue

Company Potash Ct. of America



5

Sec. 17 Twp. 6 R. 24W

Well No. #1, T.E. Logue Farm

Potash of America Company

Wildcat


Ft. from N. Line

330 Ft. from S. Line

Ft. from E. Line

330 Ft. from W. Line

SW NW

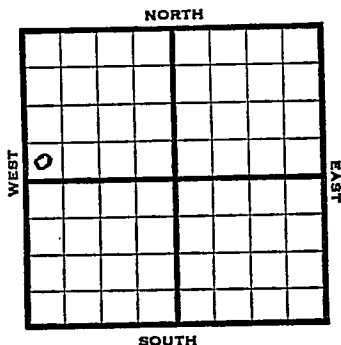

Elev. 2540

REPORT

1946

6/12

Drlg.

6/18

8" @ 2116'

Anhy 1175'

Lans 3726

Topeka 3497

Drlg 4075'

6/26

Topeka 3529

Lans 3726

BKC 3929

Cong 4155

Arb. 4 4205

TD 4255

ABANDONED

KANSAS Kansas Pool Name Wildcat

Map No. 13A Sec. 17 Twp. 6 R. 24W

Well No. 1 T. E. Logue

Potash Ct of America Company

FIRST REPORT Contractor

SW NW

SECTION PLAT

_____ Ft. from N. Line

330 Ft. from S. Line

_____ Ft. from E. Line

330 Ft. from W. Line

o			

Graham County

Location _____

Rig up _____

Drilling and Remarks:

Drlg.

RECORD

Cased _____ in., _____ ft.

Sand _____

Gas _____

Oil _____

Total Depth _____

PRODUCTION

1st 24 hrs. Nat. _____

1st 24 hrs. after shot _____

Gas _____ Cu. Ft.

Dry Hole _____

Abandoned _____

Date

JUN 1 2 1946 19

S. I. LEWIS

Scout

Kansas Pool Name Wildcat
 Map No. 134 Sec. 17 Twp. 6 R. 24W
 Well No. 1 T. E. Logue

Potash of America Company

ABANDONED

Contractor

SW NW

E 1, 2540
 SECTION PLAT

 Ft. from N. Line
330 Ft. from S. Line
 Ft. from E. Line
330 Ft. from W. Line

0			

Graham County

Location

Rig up

Drilling and Remarks:

Topoka 3529
Lions 3726
BKC 3929
Dang 4155
CLY 4205

RECORD

Cased in, ft.
 Sand
 Gas
 Oil
 Total Depth 4255

PRODUCTION

1st 24 hrs. Nat.
 1st 24 hrs. after shot
 Gas Cu. Ft.
 Dry Hole
 Abandoned

Date

JUN 26 1946 19

S. J. LEWIS

Scout