


Section 18 Township 6 Range 23W

Well No. #1 Kellogg

Company B & R Drlg.

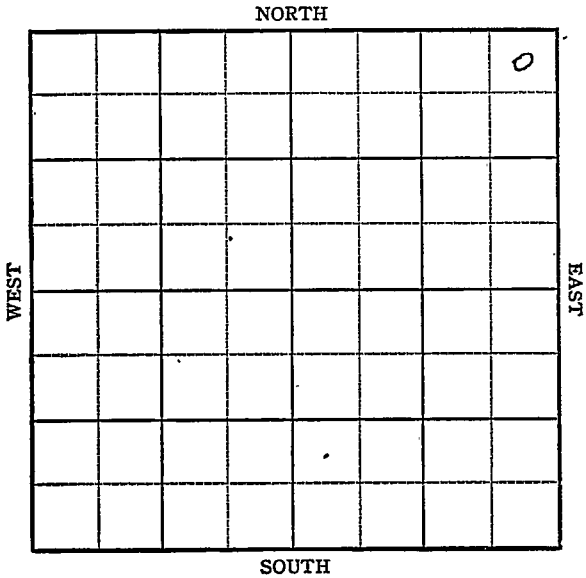



Sec. 18 Twp. 6 R. 23W

Well No. #1 Kellogg Farm

B & R Drlg. Company

Contractor

Wildcat


330' Ft. from N. Line

Ft. from S. Line

330' Ft. from E. Line

Ft. from W. Line

NE NE NE

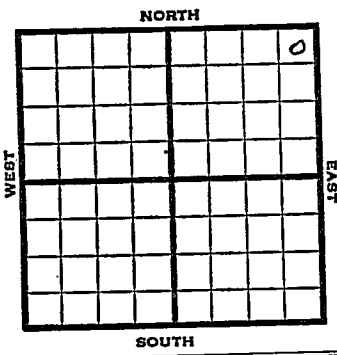

1951

Elev. 2441

REPORT

5/29

Location

6/13

D & A TD 4101' 8-4/8" @ 210
 Top. 3484', Heeb 3660', KC 3682'
 B KC 3888', Arb 4076-4101'
 D & A

ABANDONED

3682
 2441

 1241

County Graham State Kansas

Sec. 18 (Blk. 6) (Sur. 23W) (Twp. 6) (Rge. 23W) Map No.

Operator B & R Drlg.

Well No. 1 Farm Kellogg

Elev. 2441 Location NE NE NE

330 Ft. From N Line NE

330 Ft. From E Line Quarter

Ist. Report

Completion JUN 13 1951

Remarks Wildcat

Spudding Date

Drlg. Data D & A TD 4101

8 5/8" @ 210 Top. 3484 Heeb. 3660

KC 3682 B KC 3888 Arb. 4076-4101

D & A

J. E. TVRA