

32-6-19W *ok P*

SIDE ONE

STATE CORPORATION COMMISSION OF KANSAS  
OIL & GAS CONSERVATION DIVISION

WELL COMPLETION OR RECOMPLETION FORM  
ACO-1 WELL HISTORY

DESCRIPTION OF WELL AND LEASE

Operator: License # 4411  
Name Bardon Associates  
Address R.R. #4  
City/State/Zip Augusta, KS 67010

Purchaser

Operator Contact Person  
Phone

Contractor: License # 4411  
Name Abercrombie Drilling, Inc.

Wellsite Geologist Robert Lovell  
Phone (316)

Designate Type of Completion

- New Well
- Re-Entry
- Workover
- Oil
- Gas
- Dry
- SWD
- Inj
- Other (Core, Water Supply etc.)
- Temp Abd
- Delayed Comp.

If ONWO: old well info as follows:

Operator  
Well Name  
Comp. Date Old Total Depth

WELL HISTORY

Drilling Method:

- Mud Rotary
- Air Rotary
- Cable

7/8/85 7/14/85 7/14/85  
Spud Date Date Reached TD Completion Date

3544' Total Depth  
PBD

Amount of Surface Pipe Set and Cemented at 259' feet  
Multiple Stage Cementing Collar Used?  Yes  No  
If yes, show depth set feet  
If alternate 2 completion, cement circulated from feet depth to w/SX cmt

API NO. 15-163-22-714

County Rooks

SE SW SE Sec 32 Twp 6S Rge 19  East  West

330 Ft North from Southeast Corner of Section  
1650 Ft West from Southeast Corner of Section

(Note: Locate well in section plat below)


Lease Name DESMARTEAU Well # 1

Field Name LOCUST GROVE

Producing Formation ALONE

Elevation: Ground 2035 KB 2035

Section Plat

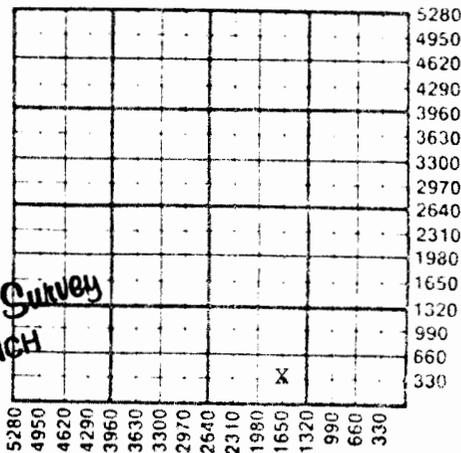

AUG 20 1985  
State Geological Survey  
WICHITA BRANCH

WATER SUPPLY INFORMATION

Disposition of Produced Water:  Disposal  Repressuring  
Docket #

Questions on this portion of the ACO-1 call:  
Water Resources Board (913) 296-3717

Source of Water:  
Division of Water Resources Permit #

Groundwater... Ft North from Southeast Corner (Well) ... Ft West from Southeast Corner of Sec Twp Rge  East  West

Surface Water... 330 Ft North from Southeast Corner (Stream, pond etc.) 200 Ft West from Southeast Corner Sec 20 Twp 7S Rge 18  East  West

Other (explain) (purchased from city, R.W.D. #)

INSTRUCTIONS: This form shall be completed in duplicate and filed with the Kansas Corporation Commission, 200 Colorado Derby Building, Wichita, Kansas 67202, within 90 days after completion or recompletion of any well. Rule 82-3-130 and 82-3-107 apply.

Information on slide two of this form will be held confidential for a period of 12 months if requested in writing and submitted with the form. See rule 82-3-107 for confidentiality in excess of 12 months. One copy of all wireline logs and drillers time log shall be attached with this form. Submit CP-4 form with all plugged wells. Submit CP-111 form with all temporarily abandoned wells.

SIDE TWO

Operator Name Bardon Associates Lease Name DESMARTEAU Well # 1

Sec. 32 Twp. 6S Rge. 19  East  West County ROCKS

WELL LOG

INSTRUCTIONS: Show important tops and base of formations penetrated. Detail all cores. Report all drill stem tests giving interval tested, time tool open and closed, flowing and shut-in pressures, whether shut-in pressure reached static level, hydrostatic pressures, bottom hole temperature, fluid recovery, and flow rates if gas to surface during test. Attach extra sheet if more space is needed. Attach copy of log.

Drill Stem Tests Taken  Yes  No  
 Samples Sent to Geological Survey  Yes  No  
 Cores Taken  Yes  No

Formation Description  
 Log  Sample

Name	Top	Bottom
TEJENA LS	3018	
HEERWER SH	3223	
JURONTE LS	3247	
L/KC Group	3263	3481
ARBuckle Dill	3536	

CASING RECORD <input type="checkbox"/> New <input type="checkbox"/> Used							
Report all strings set-conductor, surface, intermediate, production, etc.							
Purpose of String	Size Hole Drilled	Size Casing Set (in O.D.)	Weight Lbs/Ft.	Setting Depth	Type of Cement	#Sacks Used	Type and Percent Additives
Surface	12 1/4"	8 5/8"	20#	259'	Common	185	2% c.c., 3% gel
PERFORATION RECORD				Acid, Fracture, Shot, Cement Squeeze Record			
Shots Per Foot	Specify Footage of Each Interval Perforated			(Amount and Kind of Material Used)		Depth	
TUBING RECORD				Liner Run	<input type="checkbox"/> Yes <input type="checkbox"/> No		
	Size	Set At	Packer at				
Date of First Production				Producing Method			