

Sec. 19 Twp. 6 R. 22W ✓

Well No. #1 Rodgers Farm

Herndon Drlg. Company

Wildcat Contractor


 Ft. from N. Line

330' Ft. from S. Line

330' Ft. from E. Line

 Ft. from W. Line

SE SE SW

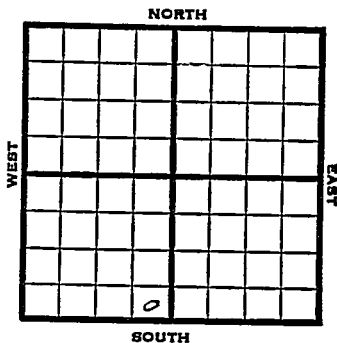

1951

Elev. 2377' REPORT

8/22
8/29


Drlg. 1500'
D&A TD 3993
Heeb. 3592 KC 3608 BKC 3815
Cong. 3895 Arb. 3920-93 TD
D&A

ABANDONED

Section 19 Township 6 Range 22W

Well No. #1 Rodgers

Company Herndon Drlg.

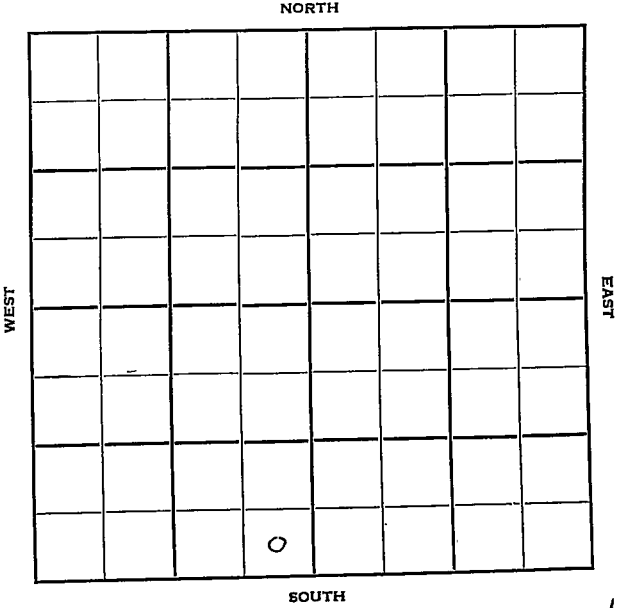

14

