


Section 19 Township 6 Range 25 W

Well No. #2 Brown

Company Jones, Shelburne & Farmer

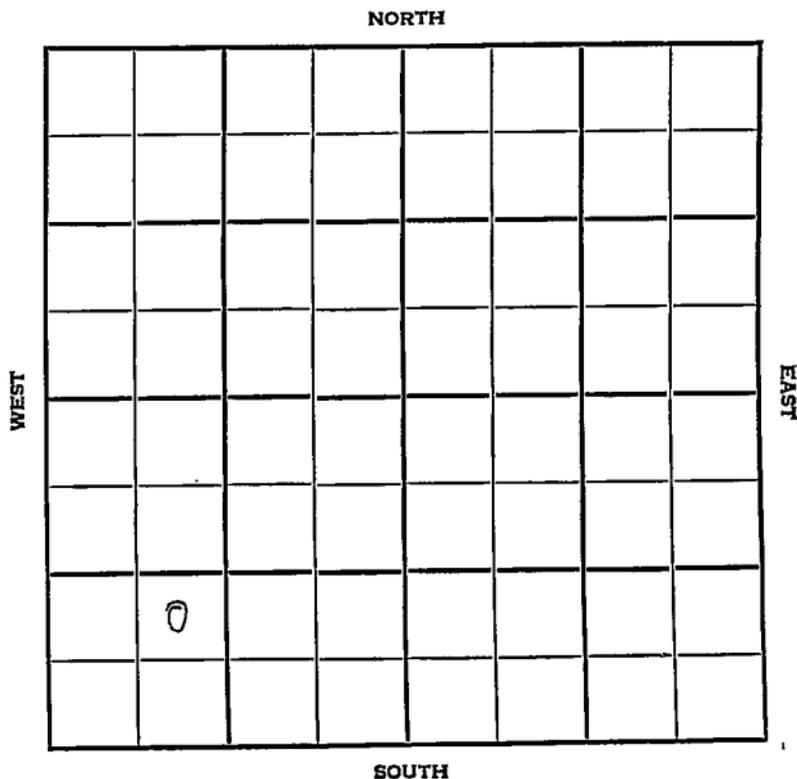

Graham

KANSAS


SEC. 19	TWP. 6	R. 25W
------------	-----------	-----------

WELL NO. #2 Brown FARM

COMPANY Jones Shelburne & Farmer

CONTRACTOR Co. Tools Allodium

_____ Ft. from N. Line
 _____ Ft. from S. Line
 _____ Ft. from E. Line
 _____ Ft. from W. Line

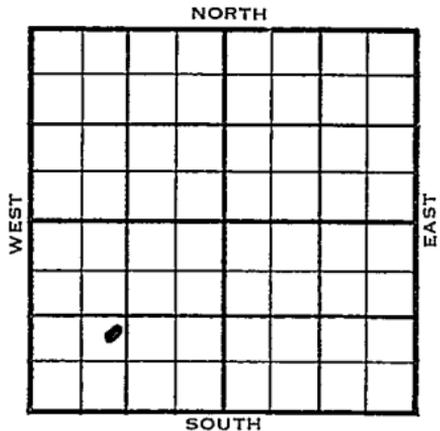

NE SW SW

1955	ELEVATION 2598 RB	2596 DE	REPORT FIRST REPORT
------	----------------------	---------	-------------------------------

8/10 Comm: 8/3/55
 8" @306/135 Drlg: 3100
 Anh. 2168.

8/17 DS^I 3716-35 open 1 hr., Rec. 25' mud
 spk oil 670# DST 3735-70 open 1 hour
 Rec. 330' msw sp oil D&A
 Anh. 2168, H: 3644, 1046, Tr: 3666,
 1068, L: 3684, 1086, BKG: 3873, 1275
 TD: 3873.

ABANDONED

County Graham Elev. 2598 RB
 Sec. 19 Twp. 6 Rge. 25W
 Company Jones, Shelburne & Farmer
 Farm Name Brown No. 2

TOPS	DEPTH	LOG	DATUM
Anh.	2168		
Tr.			
H.			
Tr.			
Dg.			
Bl.			
L.			
K.C.			
B.K.C.			
Ce.			
C.			
M.			
M.			
K.			
Mz.			
Mq.			
V.			
S.			
S.			
A			
R.			
Pe.			
G.			
T.D.			

Loc. in Sec. NE SW SW
 Geol. _____
 Contr. _____
 Co. tools _____
 Pool _____
Allodium
 FIRST REPORT
 AUG 10 '55

Date Comm. 8-3-55
8" @ 306/135 drlg. 3100

Handwritten signature/initials

Co.
 Lse.
 No.
 Sec.
 T.
 R.

2596 DF
2598 RB

County Graham Elev. _____
 Sec. 19 Twp. 6 Rge. 25W
 Company Jones, Shelburne & Farmer
 FarmName Brown No. 2

TOPS	DEPTH	LOG	DATUM	Loc. in Sec.
Dg.				
Bl.				
L.	<u>2684</u>		<u>1086</u>	Geol. _____
K.C.				Contr. _____
B.K.C.	<u>2873</u>		<u>1275</u>	Co. tools _____
Ce.				Pool _____
C.				Allodium _____
M.				<div style="border: 1px solid black; padding: 5px; text-align: center;"> <p>ABANDONED</p> <p>AUG 17 1955</p> </div>
M.				
K.				
Mz.				
Ma.				
V.				
S.				
S.				
A.				
R.				
Pe.				
G.				
Tp.	<u>2873</u>			

Date Comm. 8-3-55
8" @ 306/135 DST 3716-35 open 1 hr.
Rec. 25' mud spk. oil 670# DST 3735-70
open 1 hr. Rec. 330' msw sp. oil
D & A

Co.

Use.

No.

Sec.

T.

R.