

Graham

FORM 51

KANSAS

Section 19 Township 6 Range 25W

Well No. #1 Bradley-Salms

Company Trans-Era

NORTH

				0			

WEST

EAST

SOUTH

2

SEC.	TWP.	R.
19	6	25 W

WELL NO.

1 Bradley-Salms

FARM

COMPANY

Trans-Era

CONTRACTOR


990 Ft. from N. Line

Ft. from S. Line

Ft. from E. Line

330 Ft. from W. Line

SW NW NE

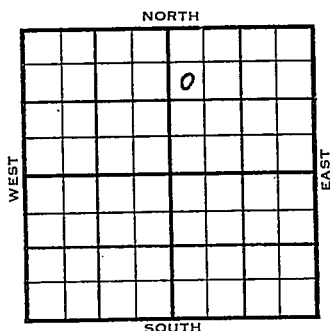

Amerada support

	ELEVATION	REPORT
1954	2600'	
1/6	Spud 1-4-54 8" @ 179 Drlg. 1985'	
1/13	Top 3496' Heeb 3659' Tor. 3681' Lans. 3697' DST 3758-78, 1 hr, 50' M 1025# Drlg. 3908'	
1/20	Spud 1-4-54 D & A TD 4200 8" @ 179 Top 3496 Heeb 3659 Tor 3681 Lans 3697 DST 3758-78 open 1 hr rec 50' mud 1025# Arb. 4172 TD 4200 D & A	

ABANDONED

County Graham State Kansas

Sec.	19	(Blk.) (Twp.)	6	(Sur.) (Rge.)	25W	Map No.
------	----	------------------	---	------------------	-----	---------

Operator Trans-Era

Well No. 1 Farm Bradley-Salms

Elev.	Location	SW	NW	NE
-------	----------	----	----	----

[illegible]

990 Ft. From **N** Line **NE**

330 Ft. From W Line Quarter

1st. Report JAN 6 1954

Completion


Remarks Amerada support

Spudding Date 1-4-54

Drlg. Data

8" @ 179 drlg. 1985

County Graham State Kansas
 Sec. 19 (Blk.) 6 (Sur.) 25W Map No. _____
 Operator Trans-Era
 Well No. 1 Farm Bradley-Salms
 Elev. 2600 Location SW NW NE

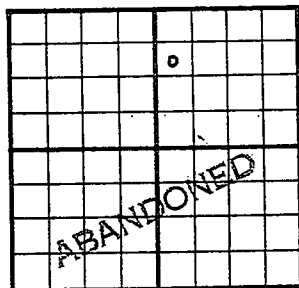

990 Ft. From N Line NE
330 Ft. From W Line Quarter

1st. Report

Completion JAN 20 1954

Remarks

Spudding Date 1-4-54

Drlg. Data D & A TD 4200

8" @ 179 Top. 3496 Heeb. 3659

Tor. 3681 Lans. 3697 DST 3758-78

open 1 hr. Rec. 50' mud 1025#

Arb. 4172 TD 4200

D & A

J. G. McGEHEE