


Section 19 Township 6 Range 25 W

Well No. #1 Simons

Company Empire Drlg.

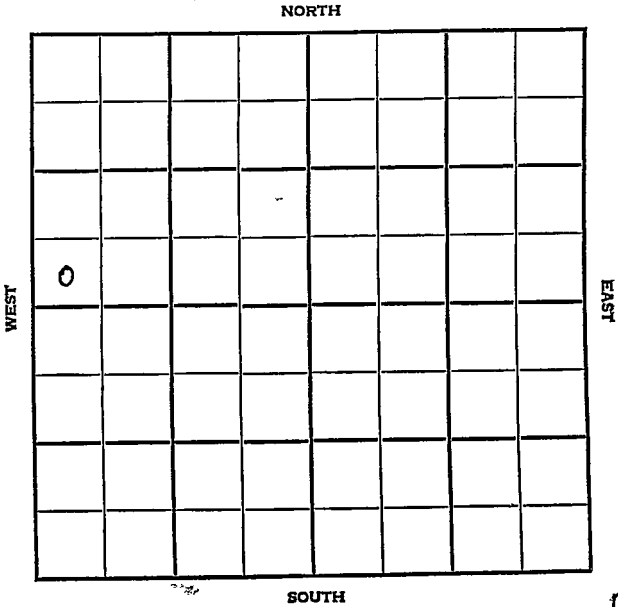

5

Graham

KANSAS

SEC.	TWP.	R.
19	6	25W

WELL NO.

#1 Simons

FARM

COMPANY

Empire Drlg.

CONTRACTOR

Co. Tools

Alloudium


Ft. from N. Line

Ft. from S. Line

Ft. from E. Line

Ft. from W. Line

SW SW NW

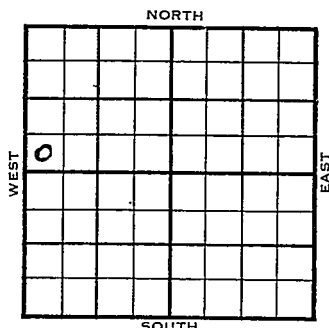

1955

ELEVATION
2604'

REPORT

7/20

Comm 7-11-55

8" @335/175 DST 3768-85 open 1 hr.

Rec. 6' mud 710/20" TD 3900, D&A

Anh. 2181, H. 3662, L. 3702, TD. 3900

FIRST REPORT

ABANDONED

County Graham Elev. 2604
 Sec. 19 Twp. 6 Rge. 25W
 Company Empire Drlg.
 Farm Name Simons No. 1

TOPS	DEPTH	LOG	DATUM	Loc. in Sec.
Anh.	2181			SW SW NW
Tp.	5662			
H.				
Tr.				
Dg.				
Bl.	3702			
L.				Geol.
K.C.				Contr.
B.K.C.				Co. tools
Ce.				Pool
C.				Alloudium
M.				
M.				
K.				
Mz.				
Mq.				
V.				
S.				
S.				
A.				
R.				
Pe.				
G.				
TD.	3900			

FIRST REPORT
 JUN-20-55
 ABANDONED

Date Comm. 7-11-55
8" @ 335/175 DST 3768-85 open 1 hr.

Rec. 6' mud 710/20" TD 3900

D & A

[Handwritten signature]