

KANSAS


Graham

FORM 51 5M 10-41 PETROL

Section 2 Township 6 Range 23-W

Well No. #1 Mills

Company Skelly Oil Co.

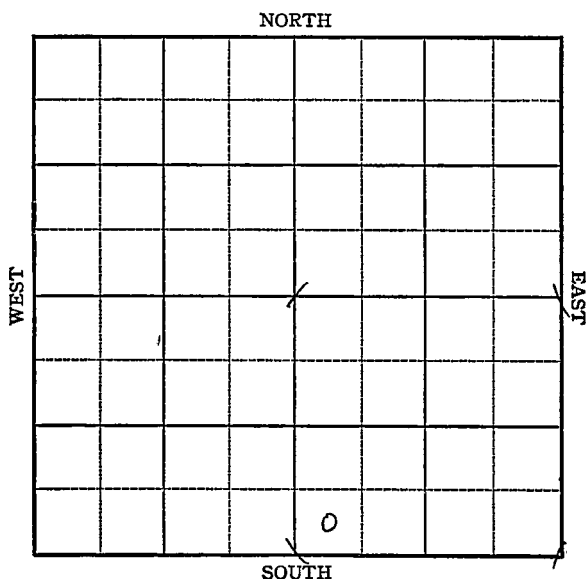

KANSAS


Graham

Sec. 2 Twp. 6 R. 23-WWell No. #1 Mills FarmSkelly Oil Co. Company

Wildcat

 Ft. from N. Line330 Ft. from S. Line Ft. from E. Line330 Ft. from W. Line

SW SE Elev. 2384

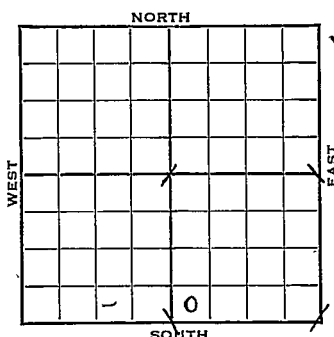

1943

REPORT

1/20 Location
1/27 Rotary.
2/3 "
2/10 8" @ 305' WOC
2/17 " " "
2/24 Brlg. 3500
3/3 Anhy 2035
Topeka 3395
Lans 3598
Arb. 3966
T.D. 3996'
No shows.

ABANDONED

KANSASMap No. 134 Sec. 2 Twp. 6 R. 23WWell No. 1 MillsSkelly

Company

Contractor


SW SE

SECTION PLAT

Ft. from N. Line

330 Ft. from S. Line

Ft. from E. Line

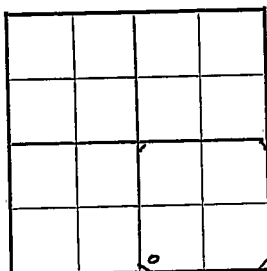330 Ft. from W. Line**WILDCA T**Location XXX

Rig up

Drilling and Remarks:

RECORD

Cased _____ in., _____ ft.

Sand _____

Gas _____

Oil _____

Total Depth _____

PRODUCTION

1st 24 hrs. Nat. _____

1st 24 hrs. after shot _____

Gas _____ Cu. Ft.

Dry Hole _____

Abandoned _____

Date

JAN 20-1943 19

S. J. LEWIS Scout

KANSAS
 Map No. 134 Sec. 2 Twp. 6 R. 23W

Well No. 1 Mills

Skelly


Company

ABANDONED

Contractor

SW SE

SECTION PLAT

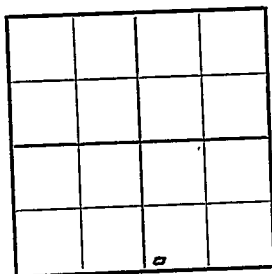

Ft. from N. Line

330 Ft. from S. Line

Ft. from E. Line

330 Ft. from W. Line

WILDCAT

Location

Rig up

Drilling and Remarks:





No show

RECORD

Cased _____ in., _____ ft.

Sand _____

Gas _____

Oil _____

Total Depth 3996

PRODUCTION

1st 24 hrs. Nat. _____

1st 24 hrs. after shot _____

Gas _____ Cu. Ft.

Dry Hole _____

Abandoned _____

Date

MAR 3 1943 19

S. J. LEWIS Scout