

KANSAS

Sheridan

FORM 51 5M BR1X

Section 2 Township 6 Range 27WWell No. #4 BoutsCompany Continental

NORTH

WEST

EAST

SOUTH

16

Sec. 2 Twp. 6 R. 27W


Well No. 4 Bouts Farm

Continental

Company

SW SE SE

NORTH

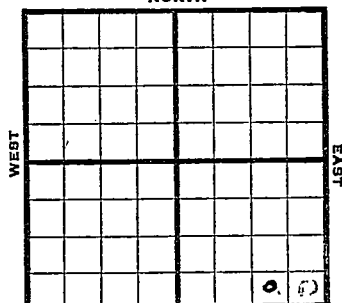

 Ft. from N. Line

330 Ft. from S. Line

990 Ft. from E. Line

 Ft. from W. Line

Adell

Elev. 2605

SOUTH

1944

R E P O R T

11/22 Location

11/29 Derrick

12/6 "

12/14 "

12/21 RUR

12/29 10" @ 236

WOC

1945

1/3 Drlg @ 407

1.10 Drlg 3345

1/17 TD 3864

6" @ 3862 Rust No tops

1/26 36 shots 3822-3844

36 shots 3810-3823

24 shots 3787-3795

36 shots 3772-3783

24 shots 3712-3720

36 shots 3695-3708 1000' oil

1/31 24 shots 3754-3762

36 shots 3670-3678 3600' fluid

SW. PB 3813

2/7 PB 3659

2/14 Reparf 3643-55 3625-33

3608-16 3590-3610; 3500 oil

OVER

1945

2/21 Lans 3494
6" @ 3862
Ripped csg. in Lans
Pump 793 Pot
TD 3864
Grav. 36.0

COMPLETED

Pool Name AdellMap No. 35 Sec. 2 Twp. 6 R. 27WWell No. 4 BoutsContinental CompanyFIRST REPORT Contractor

SW SE SE

SECTION PLAT

			o

 Ft. from N. Line330 Ft. from S. Line990 Ft. from E. Line Ft. from W. LineSheridanLocation XRig up

Drilling and Remarks:

RECORD

Cased in., ft.Sand Gas Oil Total Depth

PRODUCTION

1st 24 hrs. Nat. 1st 24 hrs. after shot Gas Cu. Ft.Dry Hole Abandoned

Date

NOV 22 1944 19S. J. LEWIS

Scout

Pool Name AdellMap No. 135 Sec. 2 Twp. 6 R. 27WWell No. 4 BoutsContinental CompanyCOMPLETED Contractor

SW SE SE

 Ft. from N. Line330 Ft. from S. Line990 Ft. from E. Line Ft. from W. Line

SECTION PLAT

			o

Sheridan

Location Rig up

Drilling and Remarks:

L. line 3494.6 "C3862Refract. log in linePump 793 ft360 ft

RECORD

Cased in., ft.Sand Gas Oil Total Depth 3864

PRODUCTION

1st 24 hrs. Nat. 1st 24 hrs. after shot Gas Cu. Ft.Dry Hole Abandoned

Date

FEB 21 1945 19

S. J. LEWIS Scout