


KANSAS

Sheridan County

Section 2 Township 6 Range 27W

Well No. #5 Bouts

Company Continental

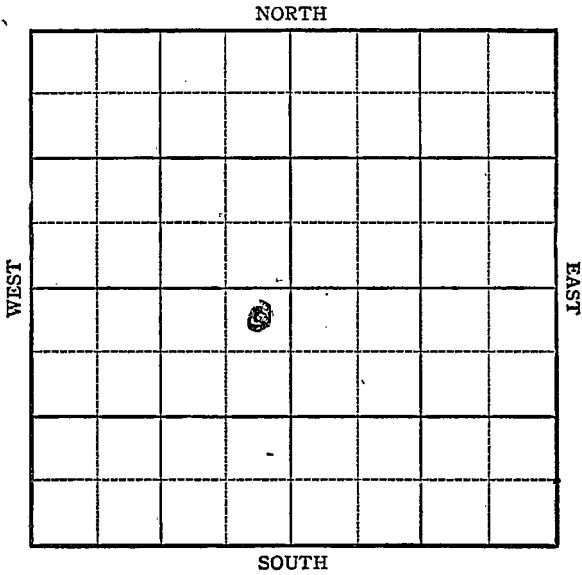

11

Sec. 2 Twp. 6S R. 27W

Well No. #5, Bouts Farm _____

Continental Company

Adell


330 Ft. from N. Line

_____ Ft. from S. Line

330 Ft. from E. Line

_____ Ft. from W. Line

NE SW *Elev. 2602*

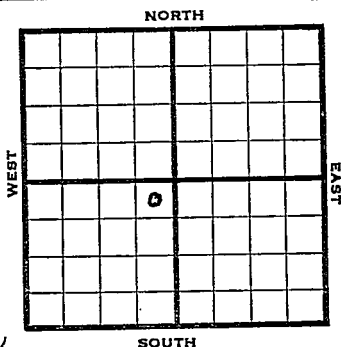

1945

R E P O R T

- 1-3 Location
- 1/10 "
- 1/17 RUR
- 1/26 10" @ 237' Drlg. 1401'
- 1/30 Drlg. 2957'
- 2/7 Drlg 3687
- 2/14 6" @ 3837
TD 3839 RUST
- 2/21 Lans. 3474
- 2/28 " "
- 3/7 33 shots 3805-16
SSO 72 shots 3738-3804 SSO
36 shots 3763-74 SSO
24 " 3747-54 SSO
9 " 3705-16 600' oil 1/2 hrs
Swb 3l oil PH
- 3/14 PB 3819
36 shots 3703-16
17 shots 3571-99 Swab
67 oil PH 4 hrs
- 3/23 " " " " "
- 3/28 Lans 3474
6" @ 3837
Perf. Lans.
TD 3839
Pump 1162 Pot.
Grav. 36.0

COMPLETED

Pool Name AdellMap No. 135 Sec. 2 Twp. 6 R. 27WWell No. 5 BoutsContinental CompanyFIRST REPORT Contractor

NE SW

SECTION PLAT

330 Ft. from N. Line

Ft. from S. Line

330 Ft. from E. Line

Ft. from W. Line

| | | | |
|--|--|---|--|
| | | | |
| | | | |
| | | o | |
| | | | |

Sheridan

Location X

Rig up _____

Drilling and Remarks:

RECORD

Cased _____ in., _____ ft.

Sand _____

Gas _____

Oil _____

Total Depth _____

PRODUCTION

1st 24 hrs. Nat. _____

1st 24 hrs. after shot _____

Gas _____ Cu. Ft.

Dry Hole _____

Abandoned _____

Date

JAN 3 1945 '19S. J. LEWIS Scout

Pool Name Adel

Map No. 35 Sec. 2 Twp. 6 R. 27 W

Well No. 5 Bouts

Continental Company

COMPLETED Contractor

NE SW

SECTION FLAT

330 Ft. from N. Line

_____ Ft. from S. Line

330 Ft. from E. Line

_____ Ft. from W. Line

| | | | |
|--|---|--|--|
| | | | |
| | | | |
| | o | | |
| | | | |

Sheridan

RECORD

Location _____

Cased _____ in., _____ ft.

Rig up _____

Sand _____

Drilling and Remarks:

Gas _____

Li aus 3474

Oil _____

6" @ 2832

Total Depth 3839

Perf Li aus .

Pump 116.2 P.D.

PRODUCTION

1st 24 hrs. Nat. _____

1st 24 hrs. after shot _____

Gas _____ Cu. Ft.

Dry Hole _____

Abandoned _____

36 2/3

Date

MAR 28 1945 19

S. J. LEWIS

Scout