


Section 2 Township 6 Range 27-W

Well No. # 6 Bouts

Company Continental
Adel

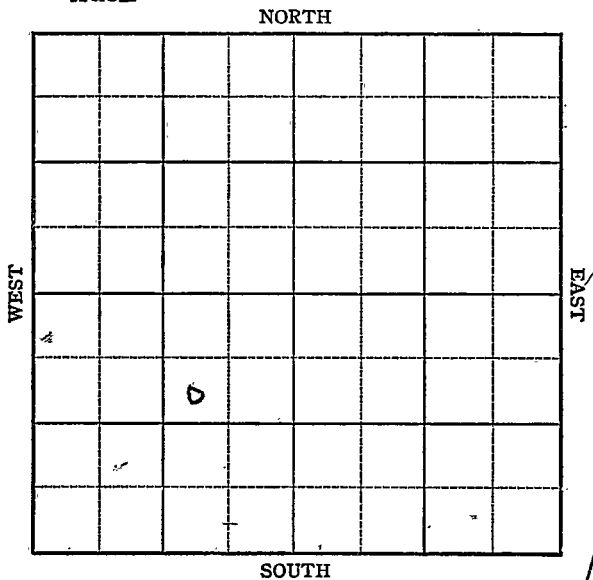

KANSAS

Sec. 2 Twp. 6 R. 27-W


Well No. # 6 Bouts Farm _____
Continental Company _____
Adel Pool

990 Ft. from N. Line

_____ Ft. from S. Line

990 Ft. from E. Line

_____ Ft. from W. Line

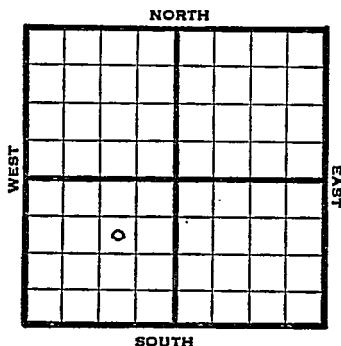

SW NE SW

1947 Elev 2579' REPORT

6/18 Location

6/21 "

7/1 10" @ 212'
Drlg 1240'

7/8 TD 3800'
Run 6"

7-16 Lansing 3528'
6" @ 3849 TD
48 shots 3626-48 swb
28 bbls oil PH- 8 hrs.

7/23 Lansing 3528'
6" @ 3849'
Perf.
Pump 604 Pot.
Gr. 34. T.D. 3850'
Completed

COMPLETED

Adel Pool

Form 26 200 Bks. 10-46 Petrol
Kansas

Map No. _____ Sec. 2 Twp. 6 R. 27W

Well No. 6 Bouts

Continental Company

FIRST REPORT

Contractor _____

SW NE SW

SECTION PLAT

990 Ft. from N. Line

_____ Ft. from S. Line

990 Ft. from E. Line

_____ Ft. from W. Line

Sheridan County

Location X

Rig up _____

Drilling and Remarks:

RECORD

Cased _____ in, _____ ft.

Sand _____

Gas _____

Oil _____

Total Depth _____

PRODUCTION

1st 24 hrs. Nat. _____

1st 24 hrs. after shot _____

Gas _____ Cu. Ft.

Dry Hole _____

Abandoned _____

Date

JUN 18 1947 19 _____

S. J. LEWIS

Scout

