


Section 2 Township 6 Range 27W

Well No. #9 Bouts

Company Continental

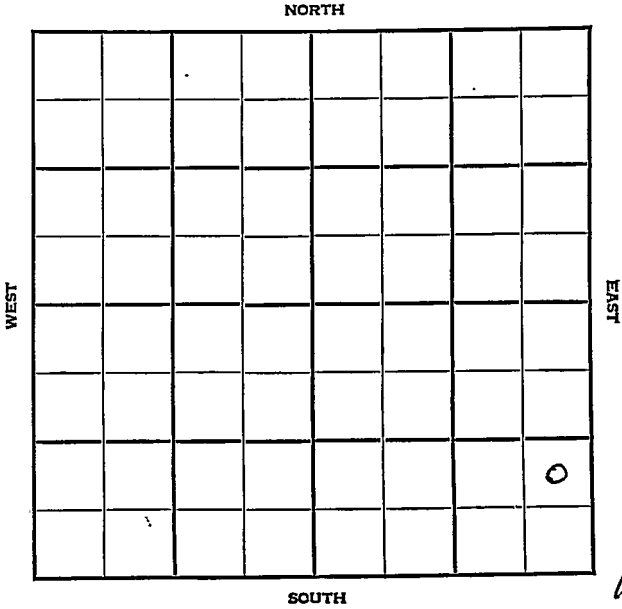

Sec. 2 Twp. 6 R. 27-W

Well No. #9 Bouts Farm

Continental Company

Adel Pool


Ft. from N. Line

990' Ft. from S. Line

330' Ft. from E. Line

Ft. from W. Line

NE SE SE

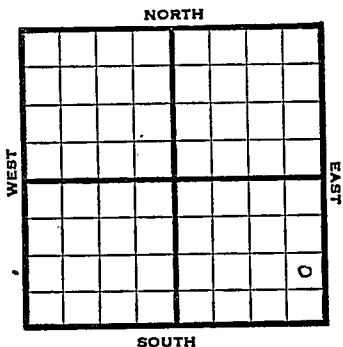

1947 Elev. 2573' REPORT

12/10 Loc.

12/17 RUR

12/30 10" @ 204'
Drlg. 3770'

1948
1/7 TD 3840'
6" @ 3839'

1/14 Lans^{ns}ing 3550'
57 shots 3647-68 swb 50 bbls water pr
hr squeeze

1/21 64 shots 3602-36'
54 " 3560-80-1000 acid 'swb 18'
bbls. oil
/ 2 W PH, 10 hrs.

1/28 Lans. 3550'
6" @ 3839'
Perf.
32 shots 3544-56' 1000 acid.
Pump 603 oil / 30% Wppot.
28.0 Gr.
TD 3840'
Comp.

COMPLETED

Adel Pool

Form 26 200 Bks. 10-46 Petrol
Kansas

Map No. _____ Sec. 2 Twp. 6 R. 27W

Well No. 9 Bouts

Continental Company

FIRST REPORT Contractor

NE SE SE

SECTION PLAT

| | | | |
|--|--|--|--|
| | | | |
| | | | |
| | | | |
| | | | |

_____ Ft. from N. Line

990 Ft. from S. Line

330 Ft. from E. Line

_____ Ft. from W. Line

Sheridan County

Location X

Rig up _____

Drilling and Remarks:

RECORD

Cased _____ in., _____ ft.

Sand _____

Gas _____

Oil _____

Total Depth _____

PRODUCTION

1st 24 hrs. Nat. _____

1st 24 hrs. after shot _____

Gas _____ Cu. Ft.

Dry Hole _____

Abandoned _____

Date

DEC 10 1947 19

S. J. LEWIS Scout

