

Sec. 2 Twp. 6 R. 27^W

Well No. #4 Bouts Farm _____

Continental Company
Adel


_____ Ft. from N. Line

330 Ft. from S. Line

_____ Ft. from E. Line

330 Ft. from W. Line

SW NW

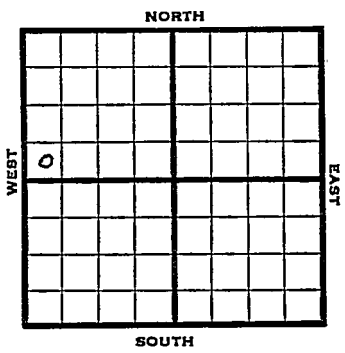

1947	REPORT
8/27	Location
9/3	10' @ 305 Drlg. 1337'
9/10	Drlg. 3432'
9/17	6" @ 3789' TD 3790'
9/24	Lansing 3511' 58 shots 3610-32' Swab $2\frac{1}{2}$ bbls. oil / $8\frac{1}{2}$ WPH 4 hrs. Squeeze.
10/1	36 shots 3696-3710' 42 shots 3676-88' 42 shots 3643-59' Swab 1 bbls. oil PH 18 hrs - 1000 acid Swab 18 bbls. oil / 12 W PH 24 hrs.
10/8	Pump 231 bbls oil & 291 W.
10/15	Squeeze perforations 3643-49' WOC
10/22	48 shots 3584-3602 64 " 3566-3580 31 " 3524-26 swb $4\frac{1}{2}$ bbls oil PH 4 hrs.

OVER

1947

10/29 Lansing 3511'
6" @ 3789'
Perf. 2000 acid
Pump 281 Pot
TD 3790'
Gravity 28

COMPLETED

Map No. _____ Sec. 2 Twp. 6 R. 27W

Well No. 4 Bouts

Continental Company

FIRST REPORT

Contractor _____

SW NW

SECTION PLAT

_____ Ft. from N. Line

330 Ft. from S. Line

_____ Ft. from E. Line

330 Ft. from W. Line

Sheridan County

Location _____

Rig up _____

Drilling and Remarks:

RECORD

Cased _____ in., _____ ft.

Sand _____

Gas _____

Oil _____

Total Depth _____

PRODUCTION

1st 24 hrs. Nat. _____

1st 24 hrs. after shot _____

Gas _____ Cu. Ft.

Dry Hole _____

Abandoned _____

Date

AUG 27 1947

19

S. J. LEWIS

Scout

