


KANSAS

Sheridan

Section 2 Township 6 Range 27W

Well No. #3 A M Bouts

Company Continental

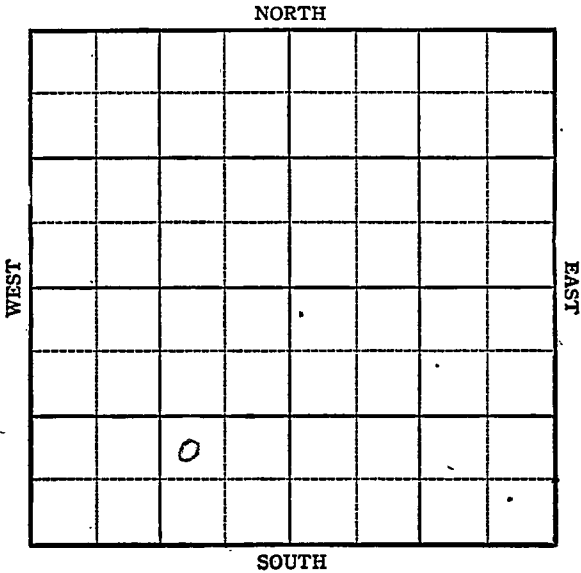

14

KANSAS

Sheridan County

Sec. 2 Twp. 6 R. 27W

Well No. #3- A.M. Bonts Farm

Continental Company


Adell

 Ft. from N. Line

990 Ft. from S. Line

990 Ft. from E. Line

 Ft. from W. Line

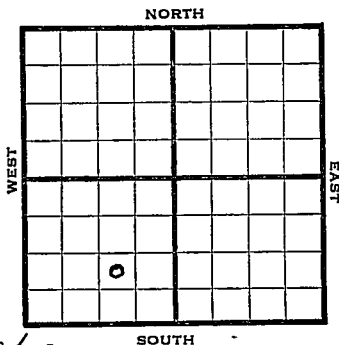

NW SE SW *Elev. 2600*

REPORT

1944

- 8/9 Drk.
- 8/16 10" @ 242 Drlg. 1320
- 8/23 Drlg. 3070'
- 8/30 Drlg. 3820
- 9/8 Lans 3619?
6" @ 3805 TD 4091 in Granite
- 9/13 " " " " " " "
- 9/21 Lans 3611 corrected
PB 3773
- 9/28 48 shots 3753-65
swb 178 oil in 4 hrs
48 shots 3734-48 No show
- 10/4 Ripped csg. 3616-24
Swb 49 bbls oil per hr 6 hrs.
- 10/11 Pump 430 in 24 hrs.
- 10/18 Lans 3611
6" @ 3805
Granite 3980
Perf. Lans.
Pump 430 Pot.
TD 4091
Grav. 42.

COMPLETED

Pool Name Adell

KANSAS
 Map No. 735 Sec. 2 Twp. 6 R. 27W

Well No. 3 A, M. Bouts

Continental Company

FIRST REPORT

Contractor

NW SE SW

SECTION PLAT

	o		

Ft. from N. Line

990 Ft. from S. Line990 Ft. from E. Line

Ft. from W. Line

Sheridan County

RECORD

Location _____

Cased _____ in., _____ ft.

Rig up _____

Sand _____

Drilling and Remarks:

Gas _____

Derrick

Oil _____

Total Depth _____

PRODUCTION

1st 24 hrs. Nat. _____

1st 24 hrs. after shot _____

Gas _____ Cu. Ft.

Dry Hole _____

Abandoned _____

Date

AUG 9 1944 19 _____

S. J. LEWIS Scout

Pool Name Adell Pool

KANSAS
Map No. 135

Sec. 2

Twp. 6

R. 27W

Well No. 3 A. M. Bouts

Continental

Company

COMPLETED

Contractor

NW SE SW

SECTION PLAT

 Ft. from N. Line

900 Ft. from S. Line

900 Ft. from E. Line

 Ft. from W. Line

Sheridan County

	0		

Location

Rig up

Drilling and Remarks:

*Lane 3611,
6" @ 3800'*

Granite @ 980'

Prof Lane.

Pump 430 R_X

422 GW

RECORD

Cased in, ft.

Sand

Gas

Oil

Total Depth 4091

PRODUCTION

1st 24 hrs. Nat.

1st 24 hrs. after shot

Gas Cu. Ft.

Dry Hole

Abandoned

Date

OCT 18 1944 19

S. J. LEWIS

Scout