

Sheridan


FORM 51 IOM 12-46 PETROL

KANSAS

Section 2 Township 6 Range 27W

Well No. 3 Pott

Company Continental

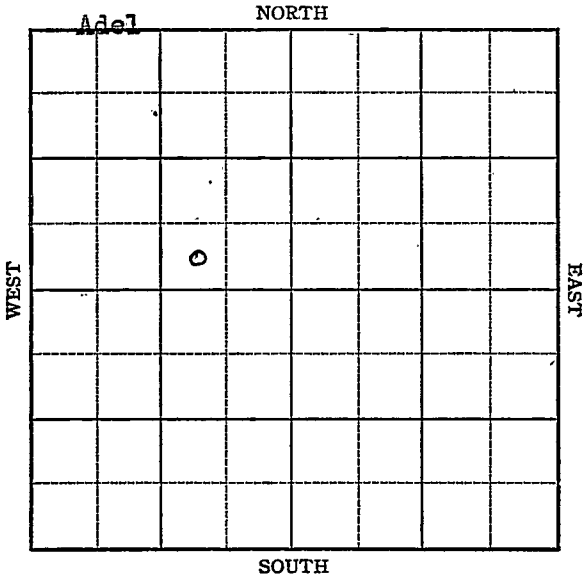

KANSAS Sheridan

Sec. 2 Twp. 6 R. 27W

Well No. #3 Bott Farm

Continental Company

Adel


 Ft. from N. Line

330 Ft. from S. Line

990 Ft. from E. Line

 Ft. from W. Line

SW SE NW

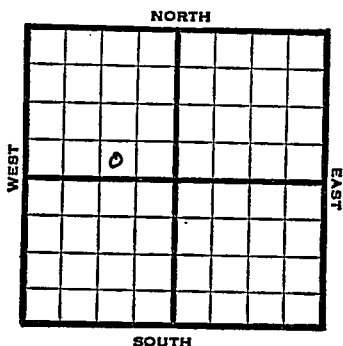

1947

Elev.

REPORT

2536'

7/23

Location

7/29

13" @ 249'
WOC

8/6

Drlg 3131'

8/13

Lansing 3498
TD 3788
6" @ 3777
RUST.

8/20

24 shots 3512-3514 - 350' oil

8/27

Lans. 3498'
6" @ 3777
Perf
1000 Acid
Pump 500 Pot
Gr. 24°
Total Depth 3788'

COMPLETED

Kansas

Map No. _____ Sec. 2 Twp. 6 R. 27WWell No. 3 Bott

Continental

Company

FIRST REPORT

Contractor

SW SE NW

SECTION PLAT

	o		

_____ Ft. from N. Line

330 Ft. from S. Line990 Ft. from E. Line

_____ Ft. from W. Line

Sheridan County

RECORD

Location X

Cased _____ in., _____ ft.

Rig up _____

Sand _____

Drilling and Remarks:

Gas _____

Oil _____

Total Depth _____

PRODUCTION

1st 24 hrs. Nat. _____

1st 24 hrs. after shot _____

Gas _____ Cu. Ft.

Dry Hole _____

Abandoned _____

Date

JUL 23 1947

19

S. J. LEWIS

Scout

Map No. 135 Sec. 2 Twp. 6 R. 27W

Well No. 3 Bouts

Continental Company

COMPLETE

Contractor

SW SE NW


E/ 2536
SECTION PLAT

 Ft. from N. Line

330 Ft. from S. Line

990 Ft. from E. Line

 Ft. from W. Line

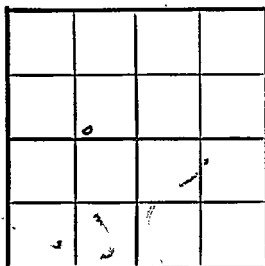

Sheridan County

Location

Rig up

Drilling and Remarks:

Lease 3498

6 "C3777

*Perf.
1000 acs*

Pump 500 B/D

240 B/D

RECORD

Cased in., ft.

Sand

Gas

Oil

Total Depth 3788

PRODUCTION

1st 24 hrs. Nat.

1st 24 hrs. after shot

Gas Cu. Ft.

Dry Hole

Abandoned

Date

AUG 27 1947 19

S. J. LEWIS

Scout